


WELL PLUGGING RECORD

Give All Information Completely
Make Required Affidavit
Mail or Deliver Report to:
Conservation Division
State Corporation Commission
800 Bittling Building
Wichita, Kansas

Kingman County. Sec. 13, Twp. 27, Rge. 10W (E) (W)
Location as "NE/CNW $\frac{1}{4}$ SW $\frac{1}{4}$ " or footage from lines NW $\frac{1}{4}$ NW $\frac{1}{4}$ SE $\frac{1}{4}$
Lease Owner Anderson-Prichard Oil Corporation
Lease Name Freeland Well No. 2
Office Address Great Bend, Kansas
Character of Well (completed as Oil, Gas or Dry Hole) dry hole
Date well completed 8-23 1951
Application for plugging filed 8-23 1951
Application for plugging approved 8-23 1951
Plugging commenced 8-23 1951
Plugging completed 8-23 1951
Reason for abandonment of well or producing formation

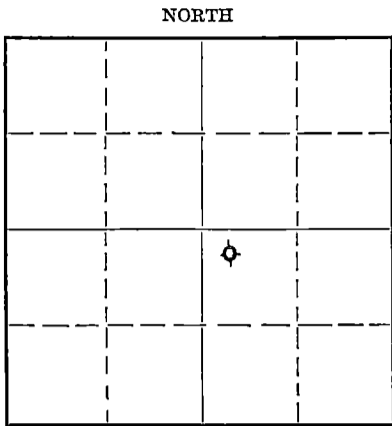

Locate well correctly on above Section Flat

If a producing well is abandoned, date of last production 19
Was permission obtained from the Conservation Division or its agents before plugging was commenced? yes
Name of Conservation Agent who supervised plugging of this well Mr. Durkee
Producing formation Depth to top Bottom Total Depth of Well 4272 Feet
Show depth and thickness of all water, oil and gas formations.

OIL, GAS OR WATER RECORDS

CASING RECORD

Formation	Content	From	To	Size	Put In	Pulled Out
				8-5/8" 2 1/2# casing	cemented	
				at 316' with 250 sacks cement		
				and 2 c.c.		

Describe in detail the manner in which the well was plugged, indicating where the mud fluid was placed and the method or methods used in introducing it into the hole. If cement or other plugs were used, state the character of same and depth placed, from feet to feet for each plug set.

Filled hole with heavy mud; set bottom plug at 270', 15 sacks cement, top plug at 35' with 10 sacks cement.

8-31-51

RECEIVED
STATE CORPORATION COMMISSION
AUG 31 1951
CONSERVATION DIVISION
Wichita, Kansas

(If additional description is necessary, use BACK of this sheet)

Correspondence regarding this well should be addressed to Anderson-Prichard Oil Corporation
Address c/o W. J. Dearen
Great Bend, Kansas

STATE OF KANSAS, COUNTY OF SEDGWICK, ss.
Birmingham-Bartlett Drilling Co., contractor (employee of same, owner, or operator) of the above-described well, being first duly sworn on oath, says: That I have knowledge of the facts, statements, and matters herein contained and the log of the above-described well as filed and that the same are true and correct. So help me God.

(Signature) Richard Hindery
300 Kaufman Building, Wichita 2, Kansas
(Address)

SUBSCRIBED AND SWORN TO before me this 28th day of August 1951

Virian J. Ginger
Notary Public.

My commission expires November 29, 1954.

PLUGGING
FILE SEC 13 T 27 R 10W
BOOK PAGE 105 LINE 30

15095-01524-000

FREELAND #2 WELL

LOCATION: NW $\frac{1}{4}$ NW $\frac{1}{4}$ SE $\frac{1}{4}$ Sec. 13-27S-10W Kingman County, Kansas
 OPERATOR: Anderson-Prichard Oil Corporation
 CONTRACTOR: Birmingham-Bartlett Drilling Co.
 SURFACE CASING: 8-5/8" 24# casing cemented at 316' with 250 sacks cement and 2 c.c.
 OIL STRING: N one. D & A.

SPUDDED: 8-7-51
 COMPLETED: 8-23-51

LOG

(Figures indicate bottom of formation)

0 to	125	Sand
	250	Red shale and shells
	316	Red bed
	705	Sand, shale and red bed
	720	Anhydrite
	1300	Shale and shells
	1530	Broken lime
	1635	Lime and shale
	1645	Lime
	2315	Lime and shale
	2620	Shale and shells
	3490	Lime and shale
	3875	Lime
	3995	Lime and shale
	4049	Cherty lime
	4060	Shale
	4105	Shale and lime
	4268	Shale
	4272	Lime
	4272	Total Depth.

The undersigned Richard Hindery of the Birmingham-Bartlett Drilling Co. hereby certifies that the above is a true and correct log of the formations encountered in drilling the Freeland #2 well as shown on the daily drilling report.

BIRMINGHAM-BARTLETT DRILLING CO.

BY Richard Hindery

Subscribed and sworn before me this 28th day of August, 1951.

Lincoln J. Gingers
Notary Public

My commission expires November 29, 1954.

RECEIVED
 STATE CORPORATION COMMISSION
 AUG 31 1951
 CORPORATION DIVISION
 Topeka, Kansas

PLUGGING
 FILE SEC 13 T27 R10W
 BOOK PAGE 105 LINE 30