

15-095-20797-0000

STATE OF KANSAS
STATE CORPORATION COMMISSION

WELL PLUGGING RECORD

Give All Information Completely
Make Required Affidavit
Mail or Deliver Report to
Conservation Division
State Corporation Comm.
245 North Water
Wichita, KS 67202

Kingman County, Sec. 13 Twp. 27s Rge. 10WE/W
Location as "NE/CNW/SW" or footage from lines

C SE NW
Lease Owner: Patton Oil Company
Lease Name: McMichael "C" Well No. 1

Office Address 5660 So. Syracuse Circle, Suite 200, Englewood
Character of Well (Completed as Oil, Gas or Dry Hole) Oil

Dry Hole


Date Well completed 3-17-79 19
Application for plugging filed 3-17-79 19
Application for plugging approved 3-17-79 19
Plugging commenced 3-17-79 19
Plugging completed 3-17-79 19
Reason for abandonment of well or producing formation

Dry Hole

If a producing well is abandoned, date of last production
N/A 19

Was permission obtained from the Conservation Division or
its agents before plugging was commenced? yes

Name of Conservation Agent who supervised plugging of this well Wm. T. Owens
Producing formation _____ Depth to top _____ Bottom _____ Total Depth of Well 1630
Show depth and thickness of all water, oil and gas formations.

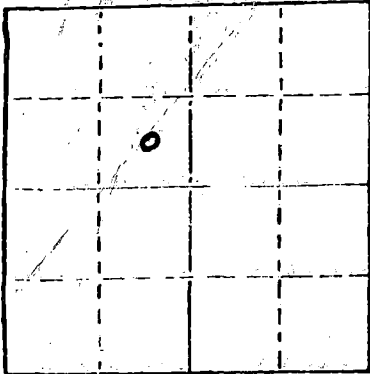

Locate well correctly on above
Section Plat

OIL, GAS OR WATER RECORDS

CASING RECORD

FORMATION	CONTENT	FROM	TO	SIZE	PUT IN	PULLED OUT
Sand				8 5/8	207'	None

Describe in detail the manner in which the well was plugged, indicating where the mud fluid was placed and the method or methods used in introducing it into the hold. If cement or other plugs were used, state the character of same and depth placed, from _____ feet to _____ feet for each plug set.

Plugged: 40 sx 210'
12 sx 40'
3 sx RH

Common 2% gel, 3% ccl

(If additional description is necessary, use BACK of this sheet)

Name of Plugging Contractor Service Company

STATE OF Kansas COUNTY OF Sedgwick, ss.
Paul A. Seymour, Jr. (employee of owner) or (owner or operator)
of the above-described well, being first duly sworn on oath, says: That I have knowledge of the facts, statements, and matters herein contained and the log of the above-described well as filed and that the same are true and correct. So help me God.

(Signature) [Signature]
Box 8287, Munger Station, Wichita, KS 67208
(Address)

SUBSCRIBED AND SWORN TO before me this 20th day of March, 19 79

Ruth M. Bassett
Ruth M. Bassett Notary Public.

My commission expires May 30, 1979

RECEIVED
STATE CORPORATION COMMISSION
MAR 22 1979
CONSERVATION DIVISION
Wichita, Kansas

15-095-20797-0000

BIG SPRINGS DRILLING, INC.

P.O. BOX 8287
MUNGER STATION
WICHITA, KANSAS 67208

SUITE 29 • 400 NORTH WOODLAWN • (316) 681-1732

March 20, 1979

DRILLERS LOG

Re: McMichael "C" # 1
C SE NW
Sec. 13-Twp 27s-Rq 10W
Kingman County, Kansas

OPERATOR: Patton Oil Company
CONTRACTOR: Big Springs Drilling, Inc.
COMMENCED: 3-15-79
COMPLETED: 3-17-79

Surface Pipe: 207' of 8 5/8" w/175 sx Common 2% gel, 3% ccl


0	210	Sand & Clay
210	700	Red Bed
700	1330	Shale
1330	1630	Lime & Shale
1630		RTD

We certify that the above and foregoing is a true and correct copy of the log on the # 1 "C" McMichael located in Kingman County, Kansas.

BIG SPRINGS DRILLING, INC.


Paul A. Seymour, Jr.

Subscribed and sworn to before me this 20th day of March, 1979.

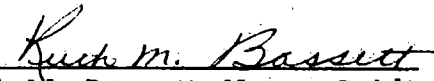
Ruth M. Bassett Notary Public

My Commission Expires:

May 30, 1979

RECEIVED
STATE CORPORATION COMMISSION

MAR 22 1979

CONSERVATION DIVISION
Wichita, Kansas