

Give All Information Completely
Make Required Affidavit
Mail or Deliver Report to:
Conservation Division
State Corporation Commission
211 No. Broadway
Wichita, Kansas

*P*owell PLUGGING RECORD

15-095-00758-0000

Kingman County, Sec. 15 Twp 27 Rge. (E) 10 (W)

Location as "NE/CNW/SW" or footage from lines NE SE SE

Lease Owner Tennessee Gas Transmission Company

Lease Name Albert McCartney Well No. 2

Office Address P. O. Box 163 - Great Bend, Kansas

Character of Well (completed as Oil, Gas or Dry Hole) Oil

Date well completed 11-30 1953

Application for plugging filed 12-18 1959

Application for plugging approved 12-18 1959


Plugging commenced 12-29 1959

Plugging completed 1-1 1960

Reason for abandonment of well or producing formation Well reached economic limit

If a producing well is abandoned, date of last production December 1957

Was permission obtained from the Conservation Division or its agents before plugging was commenced? Yes

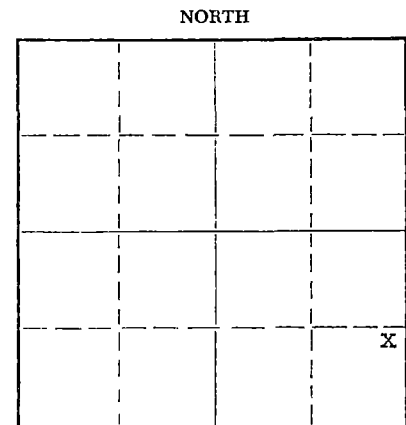

Locate well correctly on above Section Plat

Name of Conservation Agent who supervised plugging of this well Fred Hampel

Producing formation Viola Depth to top 4297' Bottom 4300' Total Depth of Well 4299' Feet

Show depth and thickness of all water, oil and gas formations.

OIL, GAS OR WATER RECORDS

CASING RECORD

| FORMATION | CONTENT | FROM | TO | SIZE | PUT IN | PULLED OUT |
|-----------|---------|------|----|--------|--------|------------|
| | | | | 8-5/8" | 227' | none |
| | | | | 5-1/2" | 4382' | 3687' |
| | | | | | | |
| | | | | | | |
| | | | | | | |
| | | | | | | |
| | | | | | | |

Describe in detail the manner in which the well was plugged, indicating where the mud fluid was placed and the method or methods used in introducing it into the hole. If cement or other plugs were used, state the character of same and depth placed, from _____ feet to _____ feet for each plug set.

Plugged from 4300' to 4270' with sand, and 5 sacks cement to 4240', bailed to 220', rock bridge from 220' to 210', run 20 sacks cement filled up to 100', mud to 40', rock bridge from 40' to 30', run 10 sacks cement from 30' to base of cellar.

(If additional description is necessary, use BACK of this sheet)

Name of Plugging Contractor Knight Casing Pulling Company

Address Chase, Kansas

STATE OF KANSAS, COUNTY OF BARTON, ss. Glen E. Armour

(employee of owner or owner or operator) of the above-described well, being first duly sworn on oath, says: That I have knowledge of the facts, statements, and matters herein contained and the log of the above-described well as filed and that the same are true and correct. So help me God.

(Signature) *Glen E. Armour*

P. O. Box 163 - Great Bend, Kansas (Address)

SUBSCRIBED AND SWORN to before me this 13th day of January, 1960

John Lemou Notary Public.

My commission expires October 13, 1962

RECEIVED STATE CORPORATION COMMISSION

JAN 14 1960

CONSERVATION DIVISION Wichita, Kansas

WELL LOG BUREAU—KANSAS GEOLOGICAL SOCIETY
508 East Murdock, Wichita, Kansas


24
15-095-00758-000

Company: BENNETT & ROBERTS OIL CORPORATION
Farm: McCartney No. 2

SEC. 15 T. 27 R. 10W
NE SE SE

Total Depth. 4300
Comm. 11-16-53 Comp. 12-5-53
Shot or Treated.
Contractor.
Issued. 3-27-54

County Kingman
KANSAS

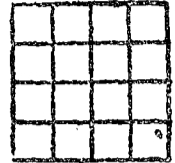

Elevation. 1765

CASING:
8 5/8 @ 223' w/ 181 sx cmt.
5 1/2 @ 4298' w/ 100 sx cmt.

Production. 86 bbls.

Figures indicate Bottom of Formations.

| | |
|----------------------|------|
| top soil & sand | 40 |
| sand | 90 |
| sand & shale | 180 |
| red shale | 223 |
| red shale & shells | 450 |
| shale & red bed | 1025 |
| anhydrite | 1050 |
| shale & shells | 1200 |
| shale & lime streaks | 1240 |
| shale & shells | 1360 |
| lime & shale streaks | 1550 |
| lime & shale | 3559 |
| lime | 3981 |
| shale & lime | 4070 |
| chert | 4085 |
| shale | 4135 |
| lime & shale | 4300 |
| Total Depth | |
| | |
| Cimarron anhydrite | 1025 |
| Heebner | 3426 |
| Lansing | 3519 |
| Kansas City | 3720 |
| Mississippi chert | 4033 |
| Kinderhook | 4115 |
| Viola | 4297 |

RECEIVED
STATE CORPORATION COMMISSION
DEC 18 1959
CONSERVATION DIVISION
Wichita, Kansas