


STATE OF KANSAS
STATE CORPORATION COMMISSION

WELL PLUGGING RECORD

Give All Information Completely
Make Required Affidavit
Mail or Deliver Report to:
Conservation Division
State Corporation Commission
800 Bittling Building
Wichita, Kansas

NORTH

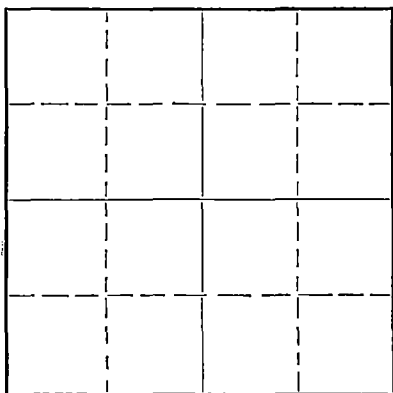

Locate well correctly on above
Section Plat

Stafford County. Sec. 8 Twp. 24S Rge. (E) 11 (W)
Location as "NE/CNW $\frac{1}{4}$ SW $\frac{1}{4}$ " or footage from lines C - E/2 - SE/4 - NE/4
Lease Owner Plains Exploration Co.
Lease Name Figger Well No. 1
Office Address Denver, Colorado
Character of Well (completed as Oil, Gas or Dry Hole) Oil
Date well completed 1 - 29 19 54
Application for plugging filed 9 - 20 19 54
Application for plugging approved 9 - 22 19 54
Plugging commenced 11 - 3 19 54
Plugging completed 11 - 8 19 54
Reason for abandonment of well or producing formation Exhausted

If a producing well is abandoned, date of last production June 19 54
Was permission obtained from the Conservation Division or its agents before plugging was commenced? Yes

Name of Conservation Agent who supervised plugging of this well Mr. M. A. Rives
Producing formation Viola Depth to top 5775' Bottom Total Depth of Well 5778 Feet
Show depth and thickness of all water, oil and gas formations.

OIL, GAS OR WATER RECORDS

CASING RECORD

Formation	Content	From	To	Size	Put In	Pulled Out
Viola	Oil	5776'	5778'	8 5/8"	231'	None
				4 1/2"	5776'	1819.30'

Describe in detail the manner in which the well was plugged, indicating where the mud fluid was placed and the method or methods used in introducing it into the hole. If cement or other plugs were used, state the character of same and depth placed, from feet to feet for each plug set.

Plugged w/ Chat to 5770'.

Dumped 5 Sks. of cement.

Mudded & set top of 20' Rock bridge at 250'.

Mixed & put in 25 Sks. of cement.

Filled hole w/ mud to 30' of base of cellar.

Set Rock bridge. Mixed & put in 10 Sks. of cement.

2-13-54

(If additional description is necessary, use BACK of this sheet)

Correspondence regarding this well should be addressed to Plains Exploration Co.
Address 525 University Bldg.
Denver 2, Colorado

STATE OF Kansas, COUNTY OF Stafford, ss.


E. E. Duncan (employee of owner) or (owner/operator) of the above-described well, being first duly sworn on oath, says: That I have knowledge of the facts, statements, and matters herein contained and the log of the above-described well as filed and that the same are true and correct. So help me God.

(Signature) E. E. Duncan
By: E. E. Duncan
Stafford, Kansas (Address)

SUBSCRIBED AND SWORN TO before me this 12th day of November, 19 54.

Dorothy McMillan
Notary Public.

My commission expires Sept 15, 1958

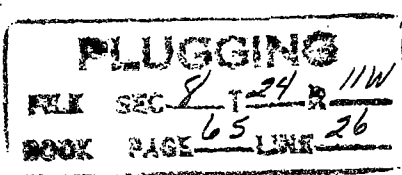

WELL LOG

PLAINS EXPLORATION CO.

FIGGER # 1

COMMENCED 1-5-44
 COMPLETED 1-29-44
 TOTAL DEPTH 3778'
 CONTRACTOR - CREEKMORE DRILLING CO.

LOCATION
 C - E/2 SE/4 NE/4
 Sec 3 - 24S - 11W
 Stafford County Kansas
 Elevation 1826' D.F.

CASING RECORD

8-5/8" Surface pipe cemented at 231'
 with 125 sacks
 4 1/2" OD Casing cemented 3776'
 with 100 sacks
 Treated with 500 gal acid
 Indicated Capacity 2537 bbl - 6% water

- 0' Rotary Bushing
 - 160' Surface, Clay and Sand
 - 240' Red Rock
 - 260' Shells & Red Rock
 - 415' Shale & Shells
 - 568' Red Bed & Shells
 - 612' Anhydrite
 - 740' Shale & Shells
 - 1430' Shale & Lime Shells
 - 1725' Broken Lime
 - 1740' Sandy Lime
 - 2025' Broken Lime
 - 2130' Lime & Shale
 - 2400' Broken Lime
 - 2520' Shale
 - 2620' Shale & Lime Shells
 - 2665' Broken Lime
 - 2730' Lime
 - 2945' Broken Lime
 - 3105' Lime
 - 3130' Shale
 - 3260' Broken Lime
 - 3435' Shale
 - 3480' Broken Lime
 - 3503' Cherty Lime
 - 3510' Sandy Lime
 - 3520' Cherty Lime
 - 3575' Lime
 - 3580' Sandy Lime
 - 3710' Lime
 - 3775' Shale
 - 3778' Lime Cherty
- TOP OF VIOLA - - - - 3775'

I HEREBY CERTIFY THE ABOVE RECORD IS
 A TRUE AND CORRECT RECORD OF THE
 DRILLERS LOG ON THIS WELL.

SIGNED E. E. Duncan

SUBSCRIBED AND SWORN TO BEFORE ME THIS
12 DAY OF Sept, 1954

[Signature]
 Notary Public

My Commission Expires Aug 4 - 1958

RECORDED
 STATE OF KANSAS

SEP 22 1954

CONSERVATION DIVISION
 Wichita, Kansas

PLUGGING
 FILE SEC 8 T 24 R 11 W
 BOOK 65 PAGE 26