


STATE OF KANSAS
STATE CORPORATION COMMISSION

Give All Information Completely
Make Required Affidavit
Mail or Deliver Report to:
Conservation Division
State Corporation Commission
800 Bittling Building
Wichita, Kansas

WELL PLUGGING RECORD

NORTH

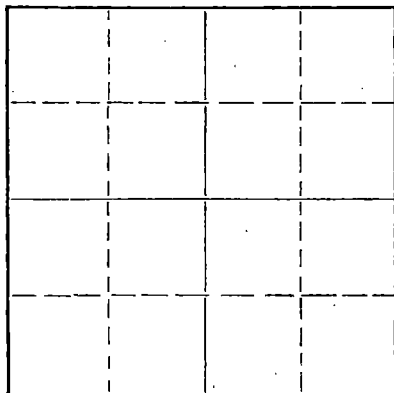

Locate well correctly on above
Section Plat

Stafford County. Sec. 7 Twp. 24 Rge. (E) 11 (W)

Location as "NE/CNW/SW" or footage from lines
Lease Owner Columbia Supply Co.
Lease Name Ranson Well No. 2
Office Address Box 293, Great Bend, Kansas
Character of Well (completed as Oil, Gas or Dry Hole) Oil
Date well completed 5/30/44 19
Application for plugging filed June 27, 1955 19
Application for plugging approved June 28, 1955 19
Plugging commenced 7-7- 19 55
Plugging completed 7-18- 19 55
Reason for abandonment of well or producing formation Well exhausted

If a producing well is abandoned, date of last production March 23, 1955 19
Was permission obtained from the Conservation Division or its agents before plugging was commenced? yes

Name of Conservation Agent who supervised plugging of this well Warren Horner
Producing formation _____ Depth to top _____ Bottom _____ Total Depth of Well 3805 Feet
Show depth and thickness of all water, oil and gas formations.

OIL, GAS OR WATER RECORDS

CASING RECORD

FORMATION	CONTENT	FROM	TO	SIZE	PUT IN	PULLED OUT

Describe in detail the manner in which the well was plugged, indicating where the mud fluid was placed and the method or methods used in introducing it into the hole. If cement or other plugs were used, state the character of same and depth placed, from _____ feet to _____ feet for each plug set.

Plugging started 7-7-55 and completed 7-18-55. Measured in to TD 3805'. Sanded back to 3780' and dumped in 5 sacks of cement. Shot casing off at 2951' and pulled pipe out of hole. Plugged well with heavy mud to 275', set permanent rock bridge, and dumped in 25 sacks of cement. Filled hole with heavy mud to 25' of top, set permanent rock bridge, and dumped in 10 sacks of cement for cap on well.

RECEIVED

7-20-55

(If additional description is necessary, use BACK of this sheet)
Name of Plugging Contractor Forbes Casing Pulling Co. d/b/a J. O. Forbes
Address P. O. Box 221, Great Bend, Kansas


STATE OF Kansas, COUNTY OF Barton, ss.
Lam Thomas (employee of owner) or (owner or operator) of the above-described well, being first duly sworn on oath, says: That I have knowledge of the facts, statements, and matters herein contained and the log of the above-described well as filed and that the same are true and correct. So help me God.

(Signature) Lam Thomas
Box 293, Great Bend, Kansas (Address)

SUBSCRIBED AND SWORN TO before me this 19th day of July, 1955

My commission expires January 17, 1959

Notary Public.

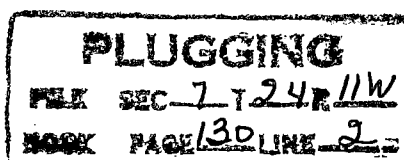

RECORD OF WELL NO. 2

MAGNOLIA PETROLEUM COMPANY

E. H. Ranson

990' FSL 990' FWL NE/4 Sec. 7-24S-11W
Stafford County, Kansas

Rig Commenced 6-16-44
Rig Completed 6-17-44

Drilling Commenced 6-18-44
Drilling Completed 7-13-44

Casing Record Put In Left In

10-3/4" 35# Lap.	286	286	Cemented w/250 Sacks
5-1/2" 14# Seamless	3793	3793	Cemented w/150 Sacks

Production - 3,000 Bbls. Max. State
Potential

Formation	Depth
red bed & sand	286
10-3/4" Csg. Set	286
red bed & shale	660
shale & shells	1430
shale & lime	1795
lime	1950
shale & lime	2105
shale & shells	2515
lime	2815
shale	2920
shale & lime	2975
lime	3045
shale & shells	3115
lime	3320
shale & lime	3370
lime	3600
lime & shale	3655
lime	3740
chert & shale	3742
Top Kinderhook	3742
Kinderhook	3792
Top Viola	3792
Viola	3793
5 1/2" Csg. Set	3793

Standardized

Viola lime 3795

Acidized

TD - SLM 3795

RECEIVED
STATE

COMPLETED

7-24-11W
130