


WELL PLUGGING RECORD

Give All Information Completely
Must be Sworn Affidavit
Must Deliver Report to:
Conservation Division
State Corporation Commission
800 Bitting Building
Wichita, Kansas

OR
FORMATION PLUGGING RECORD

Strike out upper line
when reporting plug-
ging off formations.

NORTH

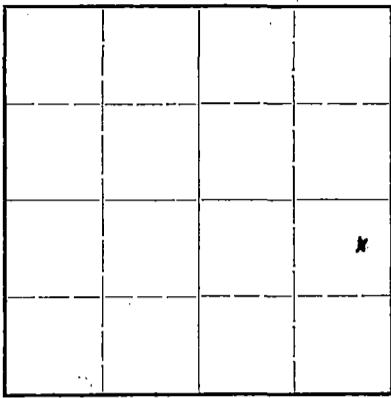

Locate well correctly on above
Section Plat

Stafford County. Sec. 9 Twp. 24S Rge. 11 (W)
Location as "NE 1/4 NW 1/4 SW 1/4" or footage from lines. C E/2 NE SE
Lease Owner Gulf Oil Corporation
Lease Name M. Figger Well No. 1
Office Address Box 661 Tulsa, Oklahoma
Character of Well (completed as Oil, Gas or Dry Hole) Oil
Date well completed 9-23-41 19
Application for plugging filed 1-25-46 19
Application for plugging approved 1-25-46 19
Plugging commenced 2-8-46 19
Plugging completed 2-13-46 19
Reason for abandonment of well or producing formation. Ceased to produce oil.

If a producing well is abandoned, date of last production 1-18-46 19
Was permission obtained from the Conservation Division or its agents before plugging was com-
menced? Yes

Name of Conservation Agent who supervised plugging of this well H. W. Kerr
Producing formation Viola Depth to top 3787' Bottom 3855' Total Depth of Well 3855' Feet
Show depth and thickness of all water, oil and gas formations.

OIL, GAS OR WATER RECORDS

CASING RECORD

Formation	Content	From	To	Size	Put In	Pulled Out
				8-5/8"	315'	0
				5-1/2"	3788'	3012'

Describe in detail the manner in which the well was plugged, indicating where the mud fluid was placed and the method or methods used in introducing it into the hold. If cement or other plugs were used, state the character of same and depth placed, from _____ feet to _____ feet for each plug set.

Filled with mud from 3855' to 3788'.
Run 6 sacks cement from 3788' to 3750'.
Filled with mud from 3750' to 315'.
Run 15 sacks cement from 315' to 275'.
Fill with mud from 275' to 30'.
Capped with 9 sacks cement.

9 24 11W
43 11

(If additional description is necessary, use BACK of this sheet)

Correspondence regarding this well should be addressed to A. M. Bell Jr.
Address Box 661
Tulsa, Oklahoma

STATE OF Kansas COUNTY OF Rice
Maple Taylor (employee of owner) or (owner or operator) of the above-described well,
being first duly sworn on oath says: That I have knowledge of the facts, statements, and matters herein contained in the log of the above-
described well as filed and that the same are true and correct. So help me God.

(Signature)

Box 544

Chase, Kansas

(Address)

SUBSCRIBED AND SWORN to before me this 14 day of March 1946

My commission expires April 24-1948

Notary Public.

WELL NO. 1 LEASE Marie Figger COMPANY Gulf Oil Corporation A.F.E. 2274
 DATE—DRILLING BEGAN 7-22-41 WELL COMPLETED 9-22-41 FIRST PRODUCTION 8-19-41
 SAND RECORD Viola Lime, 3787' 3855' TOTAL DEPTH: 3855'
 PB from 3883'
 INITIAL PRODUCTION OIL: "P" 205 barrels (94.08 in 11 hours 9-23-41)
 WATER: 33 barrels
 Corrected Gravity 41.

CASING RECORD

SIZE	WEIGHT	THD.	CLASS	MAKE	SET AT DEPTH	SACKS CEMENT	LBS. CAL. CHLO.	PULLED	LEFT IN
8-5/8"	32	8	C-1	Smls.St.	315'	133	300		315'
5-1/2"	14	8	New	Smls.St.	3788'	116			3788'

S— 24S T— 24S R— 11W

Stafford County,				
Kansas				
Center				
E28NE3SE				

RT 12-1/2' above 8-5/8" & 8' above 5-1/2"

ELEVATION— DF 1821'

SHOT: 9-6-41 with 100 quarts from 3802' - 3853'.
 ACIDIZED: 8-18-41 with 4000 gallons.
 8-23-41 with 8000 gallons.
 9-22-41 with 4000 gallons.

(See reverse side for formation record)

9 24 (116)
43 11

