

STATE OF KANSAS
STATE CORPORATION COMMISSION


WELL PLUGGING RECORD

OR
FORMATION PLUGGING RECORD

Strike out upper line
when reporting plugging
of formations.

Give All Information Completely
Make Required Affidavit
Mail or Deliver Report to:
Conservation Division
State Corporation Commission
800 Bittling Building
Wichita, Kansas

Stafford County. Sec. 9 Twp. 24s Rge. (E) 11 (W)
Location as "NE $\frac{1}{4}$ NW $\frac{1}{4}$ SW $\frac{1}{4}$ " or footage from lines 330' from East, 660' from North
Lease Owner Champlin Refining Company
Lease Name Figgar Well No. 2
Office Address Enid, Oklahoma.
Character of Well (completed as Oil, Gas or Dry Hole) Oil
Date well completed August 12, 19 41
Application for plugging filed October 15, 19 48
Application for plugging approved. (Verbal) May 11, 19 48
Plugging commenced May 12, 19 48
Plugging completed May 17, 19 48
Reason for abandonment of well or producing formation quit producing oil.

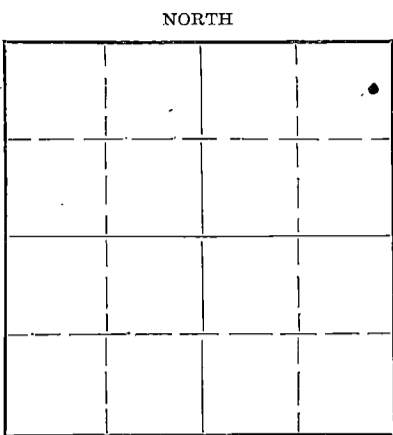

Locate well correctly on above
Section Plat

If a producing well is abandoned, date of last production October 7, 19 47
Was permission obtained from the Conservation Division or its agents before plugging was commenced? Yes
Name of Conservation Agent who supervised plugging of this well C. D. Stough, Great Bend, Kansas.
Producing formation Viola Depth to top 3768' Bottom 3800' Total Depth of Well 3800' Feet
Show depth and thickness of all water, oil and gas formations.

OIL, GAS OR WATER RECORDS

CASING RECORD

Formation	Content	From	To	Size	Put In	Pulled Out
				8 5/8" OD	305'	None
				4 1/2" OD	3768'	2909'

Describe in detail the manner in which the well was plugged, indicating where the mud fluid was placed and the method or methods used in introducing it into the hole. If cement or other plugs were used, state the character of same and depth placed, from _____ feet to _____ feet for each plug set.

Filled hole with chat from total depth 3800' to 3760' set cement plug at 3760' using 4 sacks of cement then filled hole from top of plug at 3748' with heavy mud from 3748' to 305' and set bridge and set cement plug using 15 sacks cement, filled hole with heavy mud from top of plug at 260' to 25' and used 10 sacks cement to fill hole from ~~was~~ 25' to bottom of cellar.

(If additional description is necessary, use BACK of this sheet)

Correspondence regarding this well should be addressed to Champlin Refining Company
Address P. O. Drawer, #552, Enid, Oklahoma.

STATE OF Kansas COUNTY OF Barton
S. P. Hall (employee of owner) or (owner or operator) of the above-described well,

being first duly sworn on oath, says: That I have knowledge of the facts, statements, and matters herein contained, and the log of the above-described well as filed and that the same are true and correct. So help me God.


(Signature) S. P. Hall

P. O. Box 167, Ellinwood, Kansas.
(Address)

SUBSCRIBED AND SWORN to before me this 24th. day of May, 19 48

M. Kenneth Steiner
Notary Public.

My commission expires October 24, 1951

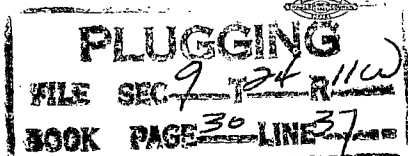


CHAMPLIN REFINING COMPANY

FIGGER #2 WELL
 CEL NE NE 9-24-11w
 Stafford County, Kansas.

FORMATION LOG

0 - 160' sand and gravel
 160' - 225' Red Bed
 225' - 305' Red Bed
 305' - 1020' Red Bed Anhydrite shells and shale
 1020' - 1300' Shale and shells
 1300' - 1420' Salt
 1420' - 1505' Anhydrite
 1505' - 1680' Lime and shale
 1680' - 1885' - shale and Lime
 1885' - 2000' Lime
 2000' - 2055' shale and lime
 2055' - 2175' Lime and shale
 2175' - 2340' Shale
 2340' - 2465' shale and shells
 2465' - 2600' shale
 2600' - 2630' shale
 2630' - 2685' shale
 2685' - 2790' shale
 2790' - 2875' shale and lime
 2875' - 2920' Lime
 2920' - 3010' Lime
 3010' - 3090' Lime
 3090' - 3130' Lime
 3130' - 3190' Broken lime
 3190' - 3240' Lime
 3240' - 3300' Lime
 3300' - 3405' Lime
 3405' - 3490' shale and lime
 3490' - 3500' shale and chert streaks
 3500' - 3510' Lime
 3510' - 3525' sand and chert
 3525' - 3540' Lime and chert
 3540' - 3590' Lime
 3590' - 3640' Lime
 3640' - 3705' shale and lime
 3705' - 3745' Shale
 3745' - 3768' Lime
 3768' - 3775' Lime
 3775' - 3780' Lime
 3780' - 3800' Lime
 3800' Total Depth

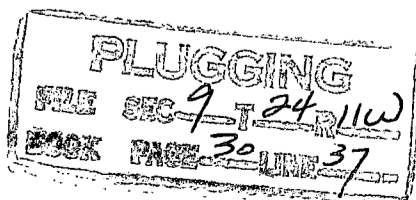

MAY 24 1944