

STATE OF KANSAS
STATE CORPORATION COMMISSION

Give All Information Completely
Make Required Affidavit
Mail or Deliver Report to:
Conservation Division
State Corporation Commission
800 Bitting Building
Wichita, Kansas


WELL PLUGGING RECORD

OR

FORMATION PLUGGING RECORD

Strike out upper line
when reporting plugging
of formations.

NORTH

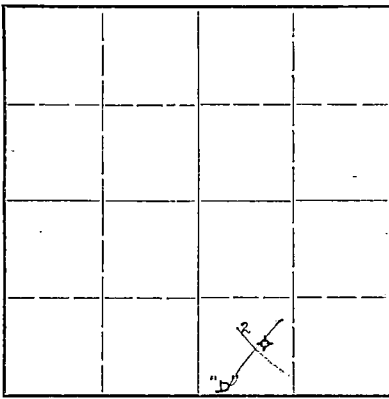

Locate well correctly on above
Section Plat

Stafford County. Sec. 10 Twp. 24 Rge. 11 (W)
Location as "NE 1/4 NW 1/4 SW 1/4" or footage from lines C-W/2-SW-SE
Lease Owner Sunray Oil Corporation
Lease Name Banker 'D' Well No. 2
Office Address Box 195, Great Bend, Kansas
Character of Well (completed as Oil, Gas or Dry Hole) Oil Well
Date well completed 7 - 16 1940
Application for plugging filed 12 - 16 1947
Application for plugging approved 12 - 17 1947
Plugging commenced 1 - 11 1948
Plugging completed 1 - 16 1948
Reason for abandonment of well or producing formation Depleted

If a producing well is abandoned, date of last production February 1947

Was permission obtained from the Conservation Division or its agents before plugging was commenced? Yes

Name of Conservation Agent who supervised plugging of this well H. W. Kerr

Producing formation Viola Depth to top 3774 Bottom 3825 Total Depth of Well 3825 Feet

Show depth and thickness of all water, oil and gas formations.

OIL, GAS OR WATER RECORDS

CASING RECORD

Formation	Content	From	To	Size	Put In	Pulled Out
Viola	Oil	3778 1/2	3832	10-3/4"	247	None
				7"	3781	2810

Describe in detail the manner in which the well was plugged, indicating where the mud fluid was placed and the method or methods used in introducing it into the hold. If cement or other plugs were used, state the character of same and depth placed, from _____ feet to _____ feet for each plug set.

Dumped crushed rock to 3764 and placed 5 sx cement on top of rock w/dump bailer. Mudded hole to 260' and dumped 15 sx cement; Mudded hole to surface and capped w/ 10 sx cement.

(If additional description is necessary, use BACK of this sheet)

Correspondence regarding this well should be addressed to Sunray Oil Corporation
Address Box 195, Great Bend, Kansas

STATE OF KANSAS, COUNTY OF BARTON, ss.
Fred McDaniel (employee of owner) or (owner or operator) of the above-described well, being first duly sworn on oath, says: That I have knowledge of the facts, statements, and matters herein contained and the log of the above-described well as filed and that the same are true and correct. So help me God.

(Signature) Fred M. Daniel Div. Engr.

(Address)

SUBSCRIBED AND SWORN to before me this 27 day of January, 1948

Walter Beck

Notary Public.

My commission expires June 10, 1950

PLUGGING
FILE SEC 10 T 24 R 11W
BOOK PAGE 5 LINE 16

1-28-48

MARY BANKER 'D' #2
 C-W/2-SW-SE
 Sec-10-24-11W
 Stafford County, Kansas
 Sunray Oil Corporation

LOG:

Sand	105	lime & shale	3150
red bed, shale	275	lime w/porus	3165
red bed & shale	537	lime	3177
hyd	556	lime broken	3221
shale & shells	950	shale & shell	3234
shale & shells	1082	shale & shell	3270
shale & shell	1414	red bed	3284
lime & shale 1440	1440	lime & shale	3298
lime & shale	1600	lime, shale, red shale	3356
shale & shells	1604	shale & red bed	3373
hyd	1636	lime	3390
lime broken	1692	lime	3403
broken lime	1714	lime & shale	3416
chert	1719	lime softin sppts, streak chert	3430
lime & chert	1740	lime w/soft porous	3482
lime & shale	1765	lime	3490
shale	1772	lime & chert	3516
cherty lime	1837	shale sticky	3527
lime & shale broken	1955	lime	3533
lime & shale	2019	lime & shale	3570
lime broken	2129	lime w/porous soft spots	3595
shale & shells	2197	lime & shale	3620
lime broken	2209	lime & chert	3666
lime & shale	2257	lime & shale	3709
broken lime	2270	shale & some chert	3740
shale	2285	shale & chert	3771
broken lime	2320	shale & lime	3800
sharp lime	2357	lime & shale	3815
shale & lime	2480	lime & chert	3832
shale & shell	2522		
lime & shale	2574	set 10 $\frac{3}{4}$ " @ 247' w/225 sax cement	
lime	2590	set 7" @ 3781' w/125 sax cement	
shale	2619		
sticky shale	2630		
broken lime	2665		
lime broken	2727		
lime	2728		
shale & shells	2822		
broken lime	2845		
shale	2870		
sharp lime	2900		
lime	2919		
lime broken	2981		
lime	3008		
shale	3015		
lime & shale st	3060		
lime	3094		
lime	3110		

I, Fred McDaniel, do hereby certify that the above is a true and complete log of Sunray Oil Corporation's Mary Banker 'D' #2 located C-E/2-SW-SE, Sec. 10-24-11W, Stafford County, Kansas.

Fred McDaniel
 Division Engineer

W. Beck
 Notary Public

January 27, 1948

My Commission Expires June 10, 1950

