

STATE OF KANSAS
STATE CORPORATION COMMISSION

WELL PLUGGING RECORD


FORMATION PLUGGING RECORD

Give All Information Completely
Make Required Affidavit
Mail or Deliver Report to:
Conservation Division
State Corporation Commission
300 Bittling Building
Wichita, Kansas

OR

Strike out upper line
when reporting plug-
ging off formations.

NORTH

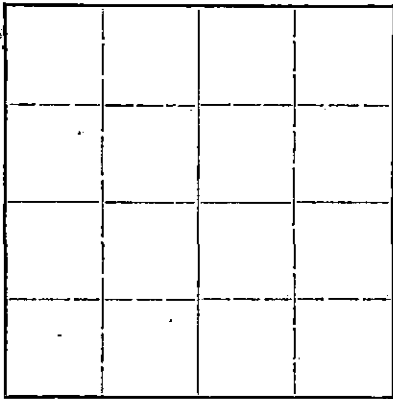

Locate well correctly on above
Section Plat

STAFFORD County. Sec. 10 Twp. 24 Rge. 11 (E) 11 (W)
Location as "NE1/4NW1/4SW1/4" or footage from lines. C-W/2-SW-SW
Lease Owner. W. E. Porter, et al
Lease Name. Richardson Well No. 4
Office Address. Denver 2, Colorado
Character of Well (completed as Oil, Gas or Dry Hole) Oil Well
Date well completed. 8-19-41 19
Application for plugging filed. 10-17-47 19
Application for plugging approved. 10-20-47 19
Plugging commenced. 2-21-48 19
Plugging completed. 3-19-48 19
Reason for abandonment of well or producing formation. Exhausted

If a producing well is abandoned, date of last production September 19 47
Was permission obtained from the Conservation Division or its agents before plugging was com-
menced? Yes

Name of Conservation Agent who supervised plugging of this well. C. D. Stough
Producing formation. viola Depth to top. 3809' Bottom. Total Depth of Well. 3831' Feet
Show depth and thickness of all water, oil and gas formations.

OIL, GAS OR WATER RECORDS

CASING RECORD

Formation	Content	From	To	Size	Put In	Pulled Out
viola	oil & water	3811'	3831'			
				8 5/8"	280'	None
				5 1/2"	3811'	3200'

Describe in detail the manner in which the well was plugged, indicating where the mud fluid was placed and the method or methods used in introducing it into the hold. If cement or other plugs were used, state the character of same and depth placed, from _____ feet to _____ feet for each plug set.

Plugged back with rock from 3831' to 3809', dumped 5 sacks cement with bailer.

Pulled Pipe

Mudded to 270', set rock bridge.

Dumped 16 sacks cement on bridge.

Mudded to 18' below bottom of cellar.

Filled to bottom of cellar with cement.

(If additional description is necessary, use BACK of this sheet)

Correspondence regarding this well should be addressed to. Plains Exploration Company
Address. Box 273 Stafford, Kansas

STATE OF KANSAS, COUNTY OF STAFFORD, ss.

(employee of owner) or (owner or operator) of the above-described well,
being first duly sworn on oath, says: That I have knowledge of the facts, statements, and matters herein contained and the log of the above-
described well as filed and that the same are true and correct. So help me God.

rec'd
3-30-48

(Signature)

C. D. Stough
Stafford, Kansas
(Address)

SUBSCRIBED AND SWORN TO before me this 29 day of March, 1948

My commission expires Aug 4 - 1950

Notary Public.

21-8858-RS 2-47-6M

PLUGGING
FILE SEC 10 T 24 R 11W
BOOK PAGE 141 LINE 1

WELL LOG BUREAU - PETROLEUM GEOLOGICAL SOCIETY
412 UNION NATIONAL BANK BLDG., WICHITA, KANSAS

PORTER-11
Porter-Richardson No. 4

NO. 10 F. 24 S. 31W
GN. 25N. 27E

County - Stafford

Total Depth. 3831
Comm. 7-26-41 (Comp. 9-19-41)
Shot or Spool used.
Contractor - Greengrove Drilling Co.
Issued - 10-13-41

CASINGS

Elevation.

Production - Pot. 3831 B.


8 5/8" 280'
5" 5811'

Figures Indicate Bottom of Penetrations.

surface clay & sand	120
red rock	455
anhydrite	585
shale	770
shale and shells	1120
lime	1420
shale	1515
broken lime	1640
broken lime and shale	1740
lime	1905
broken lime	1950
lime	2095
shale and shells	2220
shale and lime shells	2360
lime and shale	2555
broken lime and shale	2695
shale and lime	2775
broken lime and shale	2850
shale	2920
lime	3125
shale and shells	3325
shale	3510
lime	3575
shale and lime	3430
lime	3495
cherty lime	3585
lime	3685
cherty lime	3710
lime	3740
shale	3812
Cable	
dolomite	3831

Total Depth.

Top Vial 3800

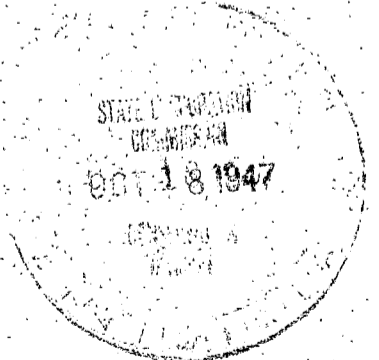

PLUGGING
NO. 10 T 24 R 11 W
PAGE 14 LINE 1