

WELL PLUGGING RECORD


STATE OF KANSAS
STATE CORPORATION COMMISSION

Give All Information Completely
Make Required Affidavit
Mail or Deliver Report to:
Conservation Division
State Corporation Commission
800 Building Building
Wichita, Kansas

OR
FORMATION PLUGGING RECORD

Strike out upper line
when reporting plug-
ging of formations.

Stafford County. Sec. 10 Twp 24 S Rge. (E) 11 (W)
Location as "NE 1/4 NW 1/4 SW 1/4" or footage from lines. G W/2 NW/4 NE/4
Lease Owner Stanolind Oil & Gas Co.
Lease Name W. Heggy Well No. 4
Office Address Box 591 Tulsa Okla.
Character of Well (completed as Oil, Gas or Dry Hole) Oil
Date well completed June 23 1940
Application for plugging filed Aug. 19 1947
Application for plugging approved Aug. 20 1947
Plugging commenced Oct. 11 1947
Plugging completed Oct. 16 1947
Reason for abandonment of well or producing formation No longer Productive

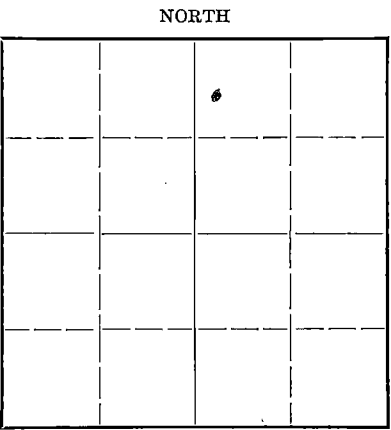

Locate well correctly on above
Section Plat

If a producing well is abandoned, date of last production July 31 1947
Was permission obtained from the Conservation Division or its agents before plugging was com-
menced? Yes

Name of Conservation Agent who supervised plugging of this well
Producing formation Viola Depth to top 3739 Bottom 3794 Total Depth of Well 3794 Feet
Show depth and thickness of all water, oil and gas formations.

OIL, GAS OR WATER RECORDS

CASING RECORD

Formation	Content	From	To	Size	Put In	Pulled Out
Viola	Oil	3739	3794	10 3/4	247	None
				7	3761	2799

Describe in detail the manner in which the well was plugged, indicating where the mud fluid was placed and the method or methods used in introducing it into the hold. If cement or other plugs were used, state the character of same and depth placed, from 3735 to 3700 feet to 250 to 210 feet for each plug set.

Filled hole with mud from 3794' to 3735'. Dumped 5 sacks cement, filled from 3735' to 3700'.
Filled with mud from 3700' to 3500'. Rip casing at 2790', pull casing. Filled with mud from
3500' to 250'. Bridge solid with rock and dump 15 sacks cement, filled from 250' to 210'.
Filled with mud from 210' to 20'. Dumped 10 sacks cement, filled from 20' to bottom of cellar.

10-29-47

(If additional description is necessary, use BACK of this sheet)

Correspondence regarding this well should be addressed to Stanolind Oil & Gas Co.
Address Box 518 Zenith Kansas

STATE OF Kansas, COUNTY OF Stafford, ss.
E. B. Snyder (employee of owner) or (owner or operator) of the above-described well,
being first duly sworn on oath, says That I have knowledge of the facts, statements, and matters herein contained and the log of the above-
described well as filed and that the same are true and correct. So help me God.


(Signature) E. B. Snyder
Zenith, Kansas (Address)

SUBSCRIBED AND SWORN to before me this 25 day of October, 1947

W. J. [Signature]
Notary Public.

My commission expires Dec. 20, 1947

My commission expires

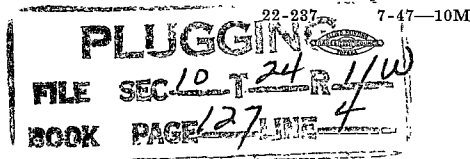

FORMATION RECORD

DESCRIBE EACH FORMATION DRILLED. INDICATE THICKNESS, CONTENT AND WHETHER DRY, OR OIL, GAS, OR WATER BEARING.

FORMATION	TOP	BOTTOM	FORMATION	TOP	BOTTOM
Cellar	0	9'2"			
Sand and red bed	9'2"	270			
Red bed	270	535			
Anhydrite	535	570			
Shale and lime	570	872			
Shale and lime shells	872	1455			
Lime and shale	1455	1567			
Broken lime and shale	1567	2853			
Lime	2853	3215			
Shale	3215	3250			
Broken shale and lime	3250	3330			
Shale	3330	3355			
Lime	3355	3455			
Broken lime and shale	3455	3518			
Lime	3518	3665			
Brown lime and shale	3665	3690			
Brown lime	3690	3715			
Shale	3715	3724			
Lime	3724	3725			
Shale	3725	3739			
Dolomite	3739	3749			
<u>Top Viola</u>	<u>3739</u>				
Lime	3749	3791			
Dolomite	3791	3794			
<u>Total Depth</u>		<u>3794</u>			