

# WELL PLUGGING RECORD


STATE OF KANSAS  
STATE CORPORATION COMMISSION

Give All Information Completely  
Make Required Report to:  
Mall or Deliver Report to:  
Conservation Division  
State Corporation Commission  
800 Bittling Building  
Wichita, Kansas

## FORMATION PLUGGING RECORD

Strike out upper line  
when reporting plugging  
off formations.

Stafford County. Sec. 15 Twp. 24S Rge. 11 (E) W. (W)  
 Location as "NE $\frac{1}{4}$ NW $\frac{1}{4}$ SW $\frac{1}{4}$ " or footage from lines. NW/4 NW/4 SE/4  
 Lease Owner. Stanolind Oil and Gas Co.  
 Lease Name. U. G. Ferris "A" Well No. 5  
 Office Address. Box 591, Tulsa, Oklahoma  
 Character of Well (completed as Oil, Gas or Dry Hole) oil  
 Date well completed June 26, 1941  
 Application for plugging filed February 24, 1949  
 Application for plugging approved February 25, 1949  
 Plugging commenced April 1, 1949  
 Plugging completed April 8, 1949  
 Reason for abandonment of well or producing formation Depletion

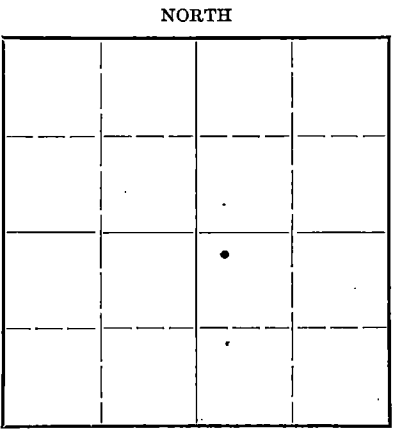

Locate well correctly on above Section Plat

If a producing well is abandoned, date of last production November 29, 1948  
 Was permission obtained from the Conservation Division or its agents before plugging was commenced? yes

Name of Conservation Agent who supervised plugging of this well Mr. C. D. Stough  
 Producing formation Viola Depth to top 3815 Bottom 3824 Total Depth of Well 3824 Feet  
 Show depth and thickness of all water, oil and gas formations.

OIL, GAS OR WATER RECORDS CASING RECORD

Formation	Content	From	To	Size	Put In	Pulled Out
Misener		3783	3798	8 5/8"	252	None
Viola	Oil	3815	3824	5 1/2"	3782	2812

Describe in detail the manner in which the well was plugged, indicating where the mud fluid was placed and the method or methods used in introducing it into the hold. If cement or other plugs were used, state the character of same and depth placed, from 3780 - 3735 feet to 256' - 201' feet for each plug set.  
 Filled with crushed rock from TD 3824' to 3780'. Dumped 5 sacks cement, filled from 3780' to 3735'. Shot casing at 2785' and pulled. Filled with mud from 3735' to 256'. Set crushed rock bridge and dumped 15 sacks cement, filled from 256' to 201'. Filled with mud from 201' to 30'. Dumped 10 sacks cement, filled from 30' to bottom of cellar.

### RECEIVED

Conservation Div. 4-15-49

APR 15 1949

STATE CORPORATION  
COMMISSION  
KANSAS

(If additional description is necessary, use BACK of this sheet)


Correspondence regarding this well should be addressed to Stanolind Oil and Gas Co.  
 Address Box 518, Zenith, Kansas

STATE OF Kansas, COUNTY OF Stafford, ss.  
 Mr. C. B. Snyder (employee of owner) or (owner or operator) of the above-described well,  
 being first duly sworn on oath, says: That I have knowledge of the facts, statements, and matters herein contained and the log of the above-described well as filed and that the same are true and correct. So help me God.

(Signature) *C. B. Snyder*  
 Field Superintendent  
 Box 518, Zenith, Kansas  
 (Address)

SUBSCRIBED AND SWORN to before me this 14th day of April, 1949  
*Paul Chadwell*  
 Notary Public.

My commission expires 1-19-52

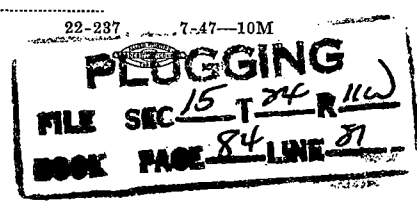



FORMATION RECORD

DESCRIBE EACH FORMATION DRILLED. INDICATE THICKNESS, CONTENT AND WHETHER DRY, OR OIL, GAS, OR WATER BEARING.

FORMATION	TOP	BOTTOM	FORMATION	TOP	BOTTOM
