


STATE OF KANSAS
STATE CORPORATION COMMISSION
Give all information completely
Make Required - Affidavit
Mail or Delivery Report to:
Conservation Division
State Corporation Commission
800 Bitting Building
Wichita, Kansas

WELL PLUGGING RECORD

Stafford County. Sec. 15 Twp. 24S Rge. (E) 11 (W)
Location as "NE/CNW $\frac{1}{4}$ SW $\frac{1}{4}$ " or footage from lines C W/2 SE SE
Lease Owner Stanolind Oil and Gas Company
Lease Name U. G. Ferris "A" Well No. 6
Office Address Box 7, Ellinwood, Kansas
Character of Well (completed as Oil, Gas or Dry Hole) Oil
Date well completed 7-11- 19 41
Application for plugging filed 3-28- 19 51
Application for plugging approved 3-30- 19 51
Plugging commenced 4-13- 19 51
Plugging completed 4-23- 19 51
Reason for abandonment of well or producing formation depleted

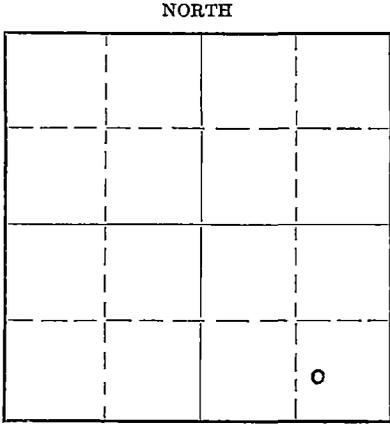

Locate well correctly on above Section Plat

If a producing well is abandoned, date of last production January, 19 51
Was permission obtained from the Conservation Division or its agents before plugging was commenced? Yes

Name of Conservation Agent who supervised plugging of this well C. D. Stough
Producing formation Misener-Viola Depth to top 3798 Bottom 3832 Total Depth of Well 3832 Feet
Show depth and thickness of all water, oil and gas formations.

OIL, GAS OR WATER RECORDS

CASING RECORD

Formation	Content	From	To	Size	Put In	Pulled Out
Misener	Oil	3798	3819	8-5/8"	234	
Viola	Oil	3819	3832	5-1/2"	3805	3108

Describe in detail the manner in which the well was plugged, indicating where the mud fluid was placed and the method or methods used in introducing it into the hole. If cement or other plugs were used, state the character of same and depth placed, from _____ feet to _____ feet for each plug set.

TD - 3832' - 3832' to 3800' - crushed rock
3800' to 3765' - cement
3765' to 240' - heavy mud
240' to 230' - crushed rock
230' to 185' - cement
185' to 35' - heavy mud
35' to 30' - crushed rock
30' to floor of cellar - cement

4-28-51

RECEIVED
STATE CORPORATION COMMISSION
APR 28 1951
CONSERVATION DIVISION
Wichita, Kansas

(If additional description is necessary, use BACK of this sheet)
Correspondence regarding this well should be addressed to Stanolind Oil and Gas Company
Address Box 7, Ellinwood, Kansas

STATE OF Kansas, COUNTY OF Barton, ss.
G. A. Younie (employee of owner) or (owner or operator) of the above-described well,
being first duly sworn on oath, says: That I have knowledge of the facts, statements, and matters herein contained and the log of the above-described well as filed and that the same are true and correct. So help me God.

(Signature) G. A. Younie Field Supt.
Box 7, Ellinwood, Kansas
(Address)

SUBSCRIBED AND SWORN to before me this 26th day of April, 1951

My commission expires November 14, 1953

D. J. A. Rader
Notary Public.

PLUGGING
FILE ON 15T 24R (W)
BOOK PAGE 70 LINE 21

FORMATION RECORD

DESCRIBE EACH FORMATION DRILLED. INDICATE THICKNESS, CONTENT AND WHETHER DRY, OR OIL, GAS, OR WATER BEARING.

FORMATION	TOP	BOTTOM	FORMATION	TOP	BOTTOM
Cellar	0	4'11"			
Sand and clay	4'11"	160			
Red bed	160	536			
Anhydrite	536	577			
Shale and shells	577	1065			
Salt and shale	1065	1170			
Shale and shells	1170	1470			
Broken lime	1470	1980			
Shale	1980	2215			
Broken lime	2215	2240			
Shale	2240	2280			
Shale and lime shells	2280	2380			
Shale	2380	2460			
Broken lime	2460	2510			
Shale and lime shells	2510	2665			
Broken lime	2665	2735			
Shale and lime shells	2735	2875	Broken lime		
Broken lime	2875	2895			
Lime	2895	3320			
Shale and shells	3320	3365			
Shale	3365	3405			
Lime	3405	3725			
Shale and shells	3725	3760			
Shale	3760	3794			
Shale and lime	3794	3804			
Lime, chert and dolomite	3804	3821			
<u>Total Depth with Rotary</u>	3821				
dolomite	3821	3826			
lime and dolomite	3826	3828			
lime	3828	3829			
lime and shale	3829	3832			
<u>Total Depth</u>	<u>3832</u>				

COPY

PLUGGING
 FILE SER-15 T-24 D-1112
 BOOK PAGE 70 LINE 21