

STATE OF KANSAS  
STATE CORPORATION COMMISSION

WELL PLUGGING RECORD

Give All Information Completely  
Make Required Affidavit  
Mail or Deliver Report to:  
Conservation Division  
State Corporation Commission  
800 Biting Building  
Wichita, Kansas

Stafford County, Sec. 15 Twp. 24S Rge. 11 (E) (W)

Location as "NE/CNW $\frac{1}{4}$ SW $\frac{1}{4}$ " or footage from lines E/2 NE SE

Lease Owner Stanolind Oil and Gas Company

Lease Name U. G. Ferris "A" Well No. 2

Office Address Box 1654, Oklahoma City, Oklahoma

Character of Well (completed as Oil, Gas or Dry Hole) Oil

Date well completed 8-9-1940

Application for plugging filed 9-11-1950

Application for plugging approved 9-13-1950


Plugging commenced 9-23-1950

Plugging completed 9-28-1950

Reason for abandonment of well or producing formation pay zone depleted  
uneconomical to operate

If a producing well is abandoned, date of last production 7-1950

Was permission obtained from the Conservation Division or its agents before plugging was commenced? Yes

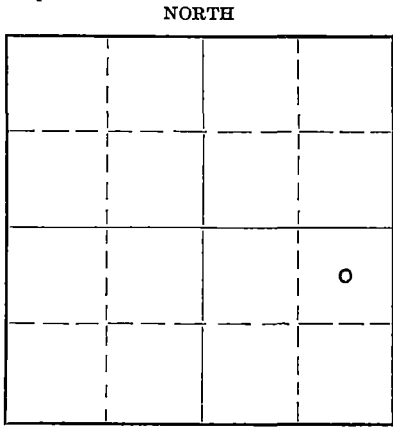

Locate well correctly on above Section Plat

Name of Conservation Agent who supervised plugging of this well

Producing formation Misener Depth to top Bottom Total Depth of Well Feet

Show depth and thickness of all water, oil and gas formations.

OIL, GAS OR WATER RECORDS

CASING RECORD

Formation	Content	From	To	Size	Put In	Pulled Out
Misener	Oil	380	3783	5 $\frac{1}{2}$ 10-3/4	3814 255	2258 None

Describe in detail the manner in which the well was plugged, indicating where the mud fluid was placed and the method or methods used in introducing it into the hole. If cement or other plugs were used, state the character of same and depth placed, from feet to feet for each plug set.

- 3829' - 3780 Rock Bridge
- 3780' - 3740' 6 sax cement
- 3740' - 260' Heavy Mud
- 260' - 250' Rock Bridge
- 250' - 205' 20 sax cement
- 205' - 30' Heavy Mud
- 30' - 8' 10 sax cement
- 8' - 0' Cellar

RECEIVED  
STATE CORPORATION COMMISSION  
OCT 10 1950  
CONSERVATION DIVISION  
Wichita, Kansas

10-10-50

(If additional description is necessary, use BACK of this sheet)

Correspondence regarding this well should be addressed to G. A. Younie

Address Box 7, Ellinwood, Kansas

STATE OF Kansas, COUNTY OF Barton, ss.


G. A. Younie (employee of owner) or (owner or operator) of the above-described well, being first duly sworn on oath, says: That I have knowledge of the facts, statements, and matters herein contained and the log of the above-described well as filed and that the same are true and correct. So help me God.

(Signature) *G. A. Younie* Field Supt.  
Box 7, Ellinwood, Kansas (Address)

SUBSCRIBED AND SWORN TO before me this 6th day of October, 1950

*D. J. Rader*  
Notary Public.

My commission expires November 14, 1953

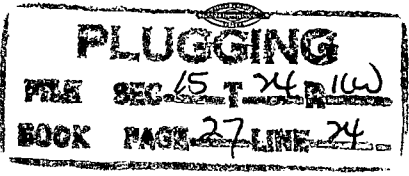



FORMATION RECORD

DESCRIBE EACH FORMATION DRILLED. INDICATE THICKNESS, CONTENT AND WHETHER DRY, OR OIL, GAS, OR WATER BEARING.

FORMATION	TOP	BOTTOM	FORMATION	TOP	BOTTOM
Cellar	0	9'8"			
Surface clay & water sand	9'8"	110			
Sand & red bed	110	265			
Shale	265	515			
Anhydrite & sand	515	545			
Red bed & shale	545	635			
Red bed	635	735			
Shale & shells & sand	735	835			
Shale and lime shells	835	1202			
Shale and salt	1202	1280			
Shale & shells	1280	1332			
Shale	1332	1483			
Anhydrite	1483	1543			
Shale, lime	1543	1711			
Shale	1711	1744			
Lime & Anhydrite	1744	1795			
Sandy lime	1795	1855			
Lime	1855	1989			
Lime & sand	1989	2019			
Lime, broken	2019	2124			
Lime & shale	2124	2174			
Lime, broken	2174	2299			
Lime	2299	2319			
Lime, shale	2319	2358			
Shale & shells	2459	2546			
Shale	2546	2566			
Shale & shells	2566	2617			
Lime & shale	2617	2689			
Shale & shells	2689	2769			
Shale	2769	2777			
Lime, broken	2777	2799			
Shale & lime	2799	2825			
Sandy lime	2825	2835			
Lime, soft	2835	2865			
Shale & sand	2865	2890			
Lime	2890	2959			
Broken lime	2959	2992			
Lime	2992	3228			
Lime & shale	3228	3270			
Lime	3270	3308			
Shale & shells	3308	3376			
Lime, shale	3376	3447			
Lime	3447	3700			
Shale & lime shells	3700	3778			
Shale	3778	3780			
Sandy lime	3780	3783			
Lime	3783	3829			
TOTAL DEPTH	3829				
Date of first work	7-9-40				
Date spudded	7-12-40				
Date drilling complete	8-7-40				
Date well complete	8-9-40				
Date potential effective	8-10-40				

**PLUGGING**  
 FILE SEC 15 T 24 R 11W  
 BOOK PAGE 27 LINE 24