15-185-10153-0000

STATE OF KANSAS
STATE CORPORATION COMMISSION

Give All Information Completely
Make Required Affidavit
Mail or Deliver Report to:
Conservation Division
State Corporation Commission
800 Bitting Building
Wichita, Kansas

WELL PLUGGING RECORD
OR
FORMATION PLUGGING RECORD

Strike out upper line when reporting plugging off formations.

NORTH

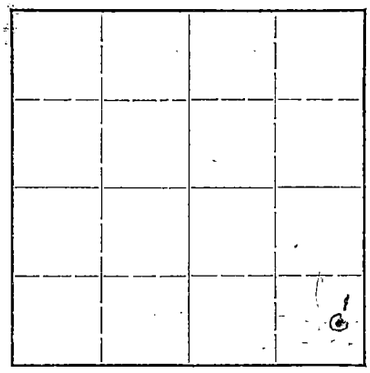

Locate well correctly on above Section Plat

Stafford County. Sec. 3 Twp. 24 Rge. (E) 11 (W)

Location as "NE¼NW¼SW¼" or footage from lines C-E/2-SE-SE

Lease Owner Sunray Oil Corporation

Lease Name Ira Johnson Well No. 1

Office Address

Character of Well (completed as Oil, Gas or Dry Hole)

Date well completed 19

Application for plugging filed 2-2 1947

Application for plugging approved 2-5 1947

Plugging commenced 2-6 1947

Plugging completed 2-18 1947

Reason for abandonment of well or producing formation Dry

If a producing well is abandoned, date of last production 19

Was permission obtained from the Conservation Division or its agents before plugging was commenced? Yes

Name of Conservation Agent who supervised plugging of this well H. W. Kerr

Producing formation Depth to top Bottom Total Depth of Well 3801 Feet

Show depth and thickness of all water, oil and gas formations.

OIL, GAS OR WATER RECORDS

CASING RECORD

Formation	Content	From	To	Size	Put In	Pulled Out
				10-3/4"	246'	None
				7"	3711'	2750'

Describe in detail the manner in which the well was plugged, indicating where the mud fluid was placed and the method or methods used in introducing it into the hold. If cement or other plugs were used, state the character of same and depth placed, from feet to feet for each plug set.

Hole was filled from bottom 3801' up into casing 3700', 5 sax cement dumped with bailer. Pipe was pulled from 2750' and hole was kept full of mud as pipe was being pulled. Rock bridge on mud at 246' and cemented with 15 sax. Finished filling with mud and cemented with 5 sax.

(If additional description is necessary, use BACK of this sheet)

Correspondence regarding this well should be addressed to Toland & Reeves

Address P. O. Box 55, Oklahoma City 1, Oklahoma

STATE OF Oklahoma, COUNTY OF Oklahoma, ss.

Gayle E. Toland (employee of owner) or (owner or operator) of the above-described well, being first duly sworn on oath, says: That I have knowledge of the facts, statements, and matters herein contained and the log of the above-described well as filed and that the same are true and correct. So help me God.

(Signature) Gayle E. Toland

P. O. Box 55, Oklahoma City, Okla.
(Address)

SUBSCRIBED AND SWORN TO before me this 5th day of July, 1947

Viola Bradley
Notary Public.

My commission expires 6-12-49

21-6838-RS 2-47—6M

PLUGGING
FILE SEC. 3 T. 24 R. 11W
BOOK PAGE 97 LINE 1

STATE CORPORATION COMMISSION
JUL 7 - 1947
CONSERVATION DIVISION