

STATE OF KANSAS  
STATE CORPORATION COMMISSION

WELL PLUGGING RECORD


Give All Information Completely  
Make Required Affidavit  
Mail or Deliver Report to:  
Conservation Division  
State Corporation Commission  
300 Bittling Building  
Wichita, Kansas

OR

FORMATION PLUGGING RECORD

Strike out upper line  
when reporting plug-  
ging off formations.

Stafford County. Sec. 3 Twp. 24 Rge. 11 (E) (W)  
Location as "NE $\frac{1}{4}$ NW $\frac{1}{4}$ SW $\frac{1}{4}$ " or footage from lines. C/ E/2 SW SE  
Lease Owner. Sunray Oil Corporation  
Lease Name. Ira Johnson Well No. 3  
Office Address.  
Character of Well (completed as Oil, Gas or Dry Hole) Oil  
Date well completed. 19 47  
Application for plugging filed. 2-2 19 47  
Application for plugging approved. 2-5 19 47  
Plugging commenced. 2-21 19 47  
Plugging completed. 3-25 19 47  
Reason for abandonment of well or producing formation. Dry

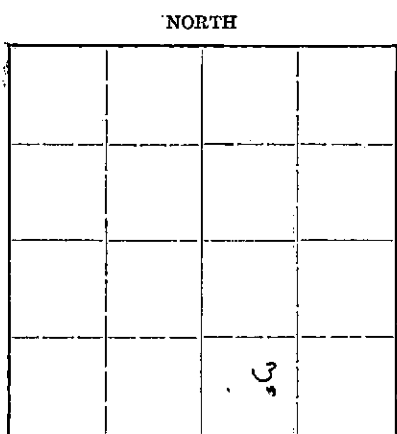

Locate well correctly on above  
Section Plat

If a producing well is abandoned, date of last production. 19  
Was permission obtained from the Conservation Division or its agents before plugging was com-  
menced? Yes

Name of Conservation Agent who supervised plugging of this well. H. W. Kerr  
Producing formation. Depth to top. Bottom. Total Depth of Well. 3775 Feet  
Show depth and thickness of all water, oil and gas formations.

OIL, GAS OR WATER RECORDS

CASING RECORD

Formation	Content	From	To	Size	Put In	Pulled Out
				10-3/4"	238'	None
				7"	3723'	1379'

Describe in detail the manner in which the well was plugged, indicating where the mud fluid was placed and the method or methods used in introducing it into the hold. If cement or other plugs were used, state the character of same and depth placed, from feet to feet for each plug set.

Dumped 5 sax of cement in bottom of well with dump bailer.  
Pipe was pulled from 1379' and hole was kept full of mud  
as pipe was being pulled. Rock bridge on mud at 238' and  
cemented with 15 sax. Finished filling with mud and  
cemented top with 5 sax.

(If additional description is necessary, use BACK of this sheet)

Correspondence regarding this well should be addressed to Toland & Reeves  
Address P. O. Box 55, Oklahoma City 1, Oklahoma

STATE OF Oklahoma COUNTY OF Oklahoma, ss.  
Gayle E. Toland (employee of owner) or (owner or operator) of the above-described well,  
being first duly sworn on oath, says: That I have knowledge of the facts, statements, and matters herein contained and the log of the above-  
described well as filed and that the same are true and correct. So help me God.

(Signature) *Gayle E. Toland*  
P. O. Box 55, Oklahoma City, Okla.  
(Address)

SUBSCRIBED AND SWORN TO before me this 5th day of July, 19 47

*Viola Bradley*  
Notary Public.

My commission expires 6-12-49

21-6858-1RS  
PLUGGING  
FILE SEC-3 T 24 R 11 W  
BOOK PAGE 94 OF 3

2-47-CM

7-7-47