

STATE OF KANSAS  
STATE CORPORATION COMMISSION

WELL PLUGGING RECORD


Give All Information Completely  
Make Required Affidavit  
Mail or Deliver Report to:  
Conservation Division  
State Corporation Commission  
800 Bittling Building  
Wichita, Kansas

OR  
FORMATION PLUGGING RECORD

Strike out upper line  
when reporting plugging  
off formations.

Stafford County, Sec. 27 Twp. 24 Rge. 14 (E) (W)  
Location as "NE 1/4 NW 1/4 SW 1/4" or footage from lines. SE SE NW  
Lease Owner. Central Supply Company  
Lease Name. Fannie B. Neill Well No. 3  
Office Address. 101 W. Cameron  
Character of Well (completed as Oil, Gas or Dry Hole) Oil  
Date well completed December 30 1944  
Application for plugging filed December 21 1949  
Application for plugging approved December 22 1949  
Plugging commenced March 15 1950  
Plugging completed April 13 1950  
Reason for abandonment of well or producing formation Reserves exhausted  
If a producing well is abandoned, date of last production June 1949  
Was permission obtained from the Conservation Division or its agents before plugging was commenced? Yes

NORTH

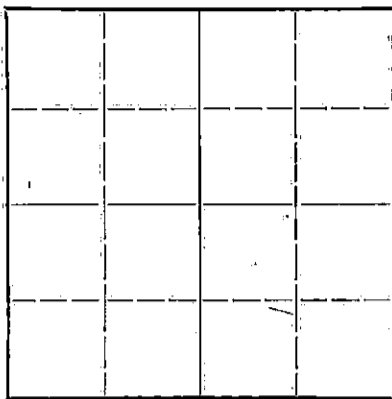

Locate well correctly on above  
Section Plat

Name of Conservation Agent who supervised plugging of this well Charlie Stough  
Producing formation Arbuckle lime Depth to top 4211 Bottom 4225 Total Depth of Well 4225 Feet  
Show depth and thickness of all water, oil and gas formations.

OIL, GAS OR WATER RECORDS

CASING RECORD

Formation	Content	From	To	Size	Put In	Pulled Out
				5 1/2"	4212 1/2	2111
				10 3/4"	889	None

Describe in detail the manner in which the well was plugged, indicating where the mud fluid was placed and the method or methods used in introducing it into the hold. If cement or other plugs were used, state the character of same and depth placed, from \_\_\_\_\_ feet to \_\_\_\_\_ feet for each plug set.

Dumped five sacks of cement at 4200'. Shot off pipe at 2100'. Pulled pipe and mudded hole to 250'. Set rock bridge and dumped 15 sacks of cement at top of surface.

RECEIVED  
APR 22 1950 4-22-50  
ST. CORPORATION  
WICHITA, KANSAS

(If additional description is necessary, use BACK of this sheet)

Correspondence regarding this well should be addressed to Central Supply Company  
Address P. O. Box 1777, Tulsa, Oklahoma

STATE OF Oklahoma, COUNTY OF Tulsa, ss.  
Sam Mizel (employee of owner) or (owner or operator) of the above-described well,  
being first duly sworn on oath, says: That I have knowledge of the facts, statements, and matters herein contained and the log of the above-described well as filed and that the same are true and correct. So help me God.

(Signature) Sam Mizel  
P.O. Box 1777 - Tulsa, Okla.  
April 1950  
Imogene Dapper Notary Public

SUBSCRIBED AND SWORN to before me this 20th day of April, 1950

My commission expires October 28, 1951

PLUGGING  
FILE SEC 27 T 20 R 14 W  
BOOK PAGE 36 LINE 8