


STATE OF KANSAS
STATE CORPORATION COMMISSION

Give All Information Completely
Make Required Affidavit
Mail or Deliver Report to:
Conservation Division
State Corporation Commission
212 North Market, Insurance Bldg.
Wichita, Kansas

WELL PLUGGING RECORD

NORTH

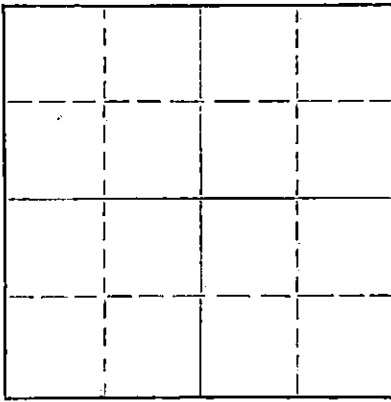

Locate well correctly on above
Section Plat

STAFFORD County. Sec. 28 Twp. 24 Rge. 14W (E) (W)Location as "NE/CNW/SW" or footage from lines SW SE SWLease Owner IMPERIAL OIL OF KANSAS, INC.Lease Name O'CONNOR Well No. 66Office Address 780 FOURTH NATIONAL BUILDING WICHITA, KANSASCharacter of Well (completed as Oil, Gas or Dry Hole) DRY HOLEDate well completed MARCH 7 19 60Application for plugging filed MARCH 7 19 60Application for plugging approved MARCH 7 19 60Plugging commenced MARCH 7 19 60Plugging completed MARCH 7 19 60Reason for abandonment of well or producing formation CORE HOLEIf a producing well is abandoned, date of last production 19Was permission obtained from the Conservation Division or its agents before plugging was commenced? YESName of Conservation Agent who supervised plugging of this well MR. FRANK BROADFOOTProducing formation Depth to top Bottom Total Depth of Well 1020 Feet

Show depth and thickness of all water, oil and gas formations.

OIL, GAS OR WATER RECORDS

CASING RECORD

FORMATION	CONTENT	FROM	TO	SIZE	PUT IN	PULLED OUT

Describe in detail the manner in which the well was plugged, indicating where the mud fluid was placed and the method or methods used in introducing it into the hole. If cement or other plugs were used, state the character of same and depth placed, from feet to feet for each plug set.

NO. 1 PLUG SET AT 250' WITH 20 SACKS
CEMENT; NO. 2 PLUG SET AT 35' WITH
10 SACKS CEMENT.

RECEIVED
STATE CORPORATION COMMISSION
APR 1 1960
CONSERVATION DIVISION
Wichita, Kansas

(If additional description is necessary, use BACK of this sheet)

Name of Plugging Contractor CHEM-TECHAddress BOX 728 HILL CITY, KANSASSTATE OF KANSAS COUNTY OF GRAHAM, ss.
DANIEL F. MCCARTHY

(employee of ~~owner~~ ~~owner~~ ~~owner~~ operator) of the above-described well, being first duly sworn on oath, says: That I have knowledge of the facts, statements, and matters herein contained and the log of the above-described well as filed and that the same are true and correct. So help me God.

(Signature)

BOX 728 HILL CITY, KANSAS
(Address)

SUBSCRIBED AND SWORN TO before me this 25 day of March 19 60My commission expires May 26, 1960

Notary Public.



RECEIVED
STATE CORPORATION COMMISSION

APR 1 1960

CONSTRUCTION DIVISION
WICHITA, KANSAS

DRILLER'S LOG

IMPERIAL OIL OF KANSAS, INC.
780 FOURTH NATIONAL BUILDING
WICHITA 2, KANSAS

O'CONNOR CORE HOLE NO. 66
SW SE SW 28-24-14W
STAFFORD COUNTY, KANSAS

TOTAL DEPTH: 1020

ELEVATION: 1982KB

COMMENCED: 3/5/60 COMPLETED: 3/7/60

CONTRACTOR: CHEM-TECH -- BOX 728
HILL CITY, KANSAS

ALL TOPS AND BOTTOMS OF THE FORMATIONS ARE CONFIDENTIAL INFORMATION OF THE GEOLOGICAL
DEPARTMENT OF IMPERIAL OIL OF KANSAS, INC.
780 FOURTH NATIONAL BUILDING
WICHITA 2, KANSAS

WE HEREBY CERTIFY THIS TO BE A CORRECT AND ACCURATE LOG OF THE ABOVE DESCRIBED WELL,
AS SHOWN ON THE DAILY DRILLING REPORTS.

CHEMICAL & TECHNICAL SERVICES, INC.

BY:

Daniel A. McCarthy
ASSISTANT TREASURER

SUBSCRIBED AND SWORN TO BEFORE ME THIS 25 DAY OF March, 1960.

MY COMMISSION EXPIRES:

Donald Law
NOTARY PUBLIC