


STATE OF KANSAS
STATE CORPORATION COMMISSION

WELL PLUGGING RECORD

Give All Information Completely
Make Required Affidavit
Mail or Deliver Report to:
Conservation Division
State Corporation Commission
211 No. Broadway
Wichita, Kansas

Stafford County, Sec. 28 Twp. 24 Rge. 14 (E) (W)

NORTH

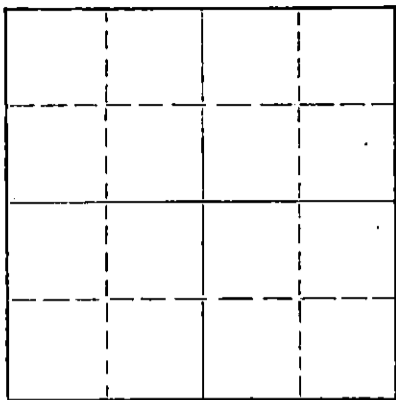

Locate well correctly on above
Section Plat

Location as "NE/CNW/SW" or footage from lines SE SW NW
Lease Owner Chief - Sunray - Bankoff
Lease Name Snyder Well No. 1
Office Address Box 97, Great Bend, Kansas
Character of Well (completed as Oil, Gas or Dry Hole) Dry Hole
Date well completed 6-13-58 19
Application for plugging filed 6-13-58 19
Application for plugging approved 19
Plugging commenced 6-13-58 19
Plugging completed 6-13-58 19
Reason for abandonment of well or producing formation Dry Hole

If a producing well is abandoned, date of last production 19
Was permission obtained from the Conservation Division or its agents before plugging was commenced? Yes

Name of Conservation Agent who supervised plugging of this well John Broadfoot, St. John, Kansas
Producing formation _____ Depth to top _____ Bottom _____ Total Depth of Well 4350' Feet
Show depth and thickness of all water, oil and gas formations.

OIL, GAS OR WATER RECORDS

CASING RECORD

FORMATION	CONTENT	FROM	TO	SIZE	PUT IN	PULLED OUT
				8 5/8"	265	None

Describe in detail the manner in which the well was plugged, indicating where the mud fluid was placed and the method or methods used in introducing it into the hole. If cement or other plugs were used, state the character of same and depth placed, from _____ feet to _____ feet for each plug set.

1/2 Sack Hulls, wooden plug @ 240', mixed 20 sacks cement through drill pipe.
1/2 Sack Hulls, wooden plug @ 40', mixed 10 sacks cement through drill pipe

6-17-58

STATE CORPORATION COMMISSION
JUN 17 1958
CONS. DIVISION
Wichita, Kansas

(If additional description is necessary, use BACK of this sheet)

Name of Plugging Contractor Chief Drilling Co., Inc.
Address Box 97, Great Bend, Kansas

STATE OF Kansas, COUNTY OF Barton, ss.
V. Richard Hoover (employee of owner) or (owner or operator) of the above-described well, being first duly sworn on oath, says: That I have knowledge of the facts, statements, and matters herein contained and the log of the above-described well as filed and that the same are true and correct. So help me God.

(Signature) V. Richard Hoover
(Address) _____

SUBSCRIBED AND SWORN TO before me this 16th day of June, 1958

My commission expires May 19, 1962
Norris Taylor
Norris Taylor, Notary Public.

PLUGGING
FILE SEC 28 T. 24 R. 14W
BOOK PAGE 108 LINE 38

W E L L L O G

No. 1 Snyder

Chief Drilling Co. - Sunray - Bankoff
Box 97
Great Bend, Kansas

Elevation: 1975 DF
1973 GRD
1978 KB

Commenced: 5-29-58
Completed: 6-13-58

No. 1 Snyder

SE SW NW Sec. 28 - 24 - 14W
Stafford County, Kansas

Contractor: Chief Drilling Co., Inc.
Rotary: 0 - 4350'

Casing Record: Set 265' of 8 5/8" casing w/200 sacks Pozmix cement, Cement circulated to surface.

Figures Indicate Bottoms of Formation

Sand & Clay	0 - 265
Shale	265 - 575
Shale & Sand	575 - 914
Anhydrite	914 - 935
Shale & Shells	935 - 1400
Shale	1400 - 1490
Shale & Shells	1490 - 1715
Lime & Shale	1715 - 3275
Lime	3275 - 3978
Lime & Shale	3978 - 4072
Chert & Shale	4072 - 4100
Shale	4100 - 4124
Sand & Shale	4124 - 4168
Chert & Lime	4168 - 4258
Shale	4258 - 4318
Dolomite	4318 - 4350
Total Depth	4350'

FORMATION TOPS & MINUS

Anhydrite	914 (+1064)
Heebner	3543 (-1565)
Brown Lime	3681 (-1703)
Lansing-K.C.	3708 (-1730)
Base K.C.	3978 (-2000)
Mississippi	4072 (-2094)
Kinderhook	4093 (-2115)
Viola	4168 (-2190)
Simpson	4258 (-2280)
Arbuckle	4318 (-2340)

State of Kansas)
County of Barton)

I hereby certify that the above is a true and correct copy of Drillers' Log of well drilled in the SE SW NW Sec. 28-24-14W, Stafford County, Kansas, to the best of my knowledge and belief.

CHIEF DRILLING CO., INC.

V. Richard Hoover
V. Richard Hoover, President

Subscribed to and sworn to before me this 16th day of June, 1958

Norris Taylor
Norris Taylor, Notary Public

My Commission Expires:

May 19, 1962

STATE COMMISSION COMMISSIONER

JUN 17 1958

STATE COMMISSION DIVISION

PLUGGING
FILE SEC. 28 T. 24 R. 14W
BOOK PAGE 108 LINE 38