

STATE OF KANSAS
STATE CORPORATION COMMISSION


Give All Information Completely
Make Required Affidavit
Mail or Deliver Report to:
Conservation Division
State Corporation Commission
211 No. Broadway
Wichita, Kansas

WELL PLUGGING RECORD

Stafford County, Sec. 21 Twp. 24S Rge. (X) 14 (W)

Location as "NE/CNWxSWx" or footage from lines NW-NE-NW
Lease Owner D. R. Lauck Oil Co., Inc.
Lease Name Suiter B Well No. 2
Office Address 301 South Broadway, Wichita, Kansas
Character of Well (completed as Oil, Gas or Dry Hole) Oil
Date well completed October 2 1955
Application for plugging filed September 6 1962
Application for plugging approved September 7 1962
Plugging commenced September 7 1962
Plugging completed September 9 1962
Reason for abandonment of well or producing formation Depleted

NORTH

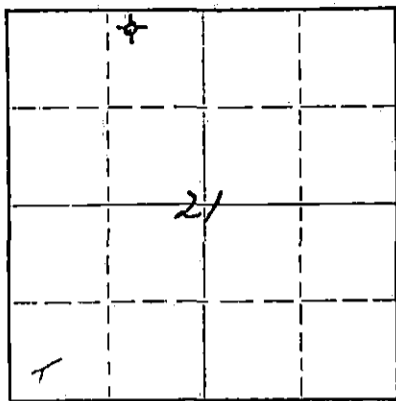

Locate well correctly on above
Section Plat

If a producing well is abandoned, date of last production August 24 1962
Was permission obtained from the Conservation Division or its agents before plugging was commenced? Yes

Name of Conservation Agent who supervised plugging of this well Mr. W. L. Lackamp
Producing formation Arbuckle Depth to top 4302 Bottom 4312 Total Depth of Well 4312 Feet
Show depth and thickness of all water, oil and gas formations. P.B. 4140

OIL, GAS OR WATER RECORDS

CASING RECORD

FORMATION	CONTENT	FROM	TO	SIZE	PUT IN	PULLED OUT
Lansing	Dry	3696	4067	8 5/8	217	None
Kinderhook	Dry	4067	4247	5 1/2	4302	3569
Simpson	Dry	4267	4302			
Arbuckle	Oil	4302	4312			

Describe in detail the manner in which the well was plugged, indicating where the mud fluid was placed and the method or methods used in introducing it into the hole. If cement or other plugs were used, state the character of same and depth placed, from _____ feet to _____ feet for each plug set.

Baker Plug	4140
Sand	4140 to 4090
5 Sx. Cement	4090 to 4060
Mud	4060 to 210
Rock Bridge and 20 Sx. Cement	210 to 140
Mud	140 to 40
Rock and 10 Sx. Cement	40 to cellar base

RECEIVED
STATE CORPORATION COMMISSION
SEP 20 1962
9-20-62
CONSERVATION DIVISION
Wichita, Kansas

(If additional description is necessary, use BACK of this sheet)

Name of Plugging Contractor Glenn and Smith Pipe Pulling Co.
Address P. O. Box 114, Ellinwood, Kansas

STATE OF Kansas, COUNTY OF Barton, ss.
H. E. Wolfe (employee of owner) or (owner or operator) of the above-described well, being first duly sworn on oath, says: That I have knowledge of the facts, statements, and matters herein contained and the log of the above-described well as filed and that the same are true and correct. So help me God.

(Signature) H. E. Wolfe
P. O. Box 488, Ellinwood, Kansas
(Address)

SUBSCRIBED AND SWORN TO before me this 17th day of September, 1962

My commission expires 8-21-65

Notary Public.

INVOICED
DATE 9/20/62
INV. NO. 5928-W

D. R. Lauck Oil Company, Inc. and
Sunray Mid-Continent Oil Company

NW NE NW Sec. 21-24S-14W
Stafford County, Kansas

Suiter "B" 2

Commenced: August 19, 1956
Completed: September 2, 1956

Casing Record: 216' 8-5/8" cem. w/165 sx
4304' 5 1/2" cem. w/125 sx

Elevation: GR 1974; DF 1977; KB 1979;

Drillers Log

		<u>Tops</u>	
		<u>Sample</u>	<u>Schlumberger</u>
surface clay & sand	50	Heebner	3535-1556
sand & clay	160	Brown Lime	3678-1699
shale & shells	360	Lansing	3696-1717
sand	495	Base Kansas City	3962-1983
red bed-shells	645	Kinderhook	4067-2088
red bed-shale	915	Simpson	4245-2266
Anhydrite	935	Arbuckle	4302-2323
shale & shells	1400	Rotary Total Depth	4305-2326
salt & shale	1550		
shale & shells	1765		
lime & shale	2330	DST #1 (W) 4092-4132	open 30 min;
lime shells & shale	2435		weak blow 8 min. recovered
shale & lime	3110		20' mud with few oil specks.
lime & shale	3425		BHP 60# in 20 min.
lime	3495		
lime & shale	3660		
shale	3678		
lime	3920		
lime & shale	4085		
cherty shale	4125		
chert	4230		
shale	4302		
Arbuckle	4305		
rotary total depth	4305		

RECEIVED
STATE CORPORATION COMMISSION
SEP 11 1962
CONSERVATION DIVISION
Wichita, Kansas