


STATE OF KANSAS
STATE CORPORATION COMMISSION

Give All Information Completely
Make Required Affidavit
Mail or Deliver Report to:
Conservation Division
State Corporation Commission
800 Bittling Building
Wichita, Kansas

WELL PLUGGING RECORD

NORTH

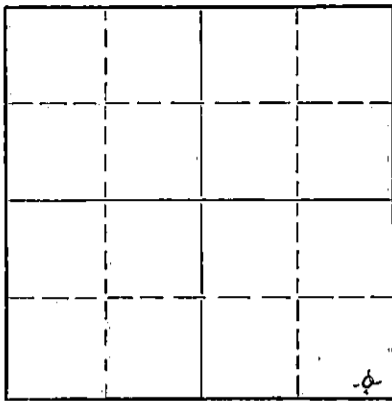

Locate well correctly on above
Section Plat

Stafford County, Sec. 23 Twp. 24S Rge. 14W (E) (W)

Location as "NE/CNW/SW" or footage from lines SE SE SE
Lease Owner Producers Pipe and Supply Company
Lease Name Koelsch Well No. 1
Office Address Box 1814, Tulsa, Oklahoma
Character of Well (completed as Oil, Gas or Dry Hole) Dry hole
Date well completed March 4 1953
Application for plugging filed March 4 1953
Application for plugging approved March 4 1953
Plugging commenced 4:00 p.m., March 4 1953
Plugging completed 8:00 p.m., March 4 1953
Reason for abandonment of well or producing formation
Commercial quantity of oil not found
If a producing well is abandoned, date of last production 19
Was permission obtained from the Conservation Division or its agents before plugging was commenced? Yes

Name of Conservation Agent who supervised plugging of this well C. E. Stough
Producing formation _____ Depth to top _____ Bottom _____ Total Depth of Well 4265 Feet
Show depth and thickness of all water, oil and gas formations.

OIL, GAS OR WATER RECORDS

CASING RECORD

FORMATION	CONTENT	FROM	TO	SIZE	PUT IN	PULLED OUT
				8 5/8	287	

Describe in detail the manner in which the well was plugged, indicating where the mud fluid was placed and the method or methods used in introducing it into the hole. If cement or other plugs were used, state the character of same and depth placed, from _____ feet to _____ feet for each plug set.

Fill hole to 270 feet plug and 20 sacks cement through drill pipe.
Fill hole to 35 feet plug and 10 sacks cement

RECORDED
STATE CORPORATION COMMISSION
MAR 17 1953
CONSERVATION DIVISION
Wichita, Kansas

(If additional description is necessary, use BACK of this sheet)
Name of Plugging Contractor K & E Drilling, Inc.
Address 1006 Central Building, Wichita, Kansas

STATE OF Kansas, COUNTY OF Sedgwick, ss.
Clinton Engstrand, agent for (employee of owner) or (owner or operator) of the above-described well, being first duly sworn on oath, says: That I have knowledge of the facts, statements, and matters herein contained and the log of the above-described well as filed and that the same are true and correct. So help me God.

(Signature) Clinton Engstrand
1006 Central Building, Wichita, Kansas
(Address)

SUBSCRIBED AND SWORN TO before me this 12 day of March, 1953

Willard Boyd
Notary Public.

My commission expires 10-29-55

PLUGGING
FILE SEC 23 T 24 R 14W
BOOK PAGE 82 LINE 32

FRUITERS PIPE AND SUPPLY COMPANY
No. 1 KOELSCH

SE SE SE Sec. 23-24S-14W
Stafford County, Kansas

Casing
8 5/8" set @ 287'

Cement
165 sacks

Comm: 2-12-53
Comp: 3-4-53
Total Depth: 4265'

FORMATION

DEPTH

Surface and sand	0 - 40
Surface soil and sand	40 - 75
Lime rock and shale and sand	75 - 265
Red bed and shale	265 - 287
Shale and shells	287 - 375
Red bed	375 - 715
Red bed	715 - 829
Anhydrite	829 - 852
Shale and shells	852 - 1390
Shale and shells	1390 - 1415
Lime and shale	1415 - 2560
Lime and shale	2560 - 3180
Lime	3180 - 3345
Lime and shale	3345 - 3380
Lime	3380 - 3560
Lime and shale	3560 - 3645
Lime	3645 - 3955
Lime, shale and chert	3955 - 4105
Lime and chert	4105 - 4150
Lime and shale	4150 - 4185
Lime, shale and sand	4185 - 4220
Lime and shale	4220 - 4240
Lime	4240 - 4265

STATE OF KANSAS)
) SS
SEDGWICK COUNTY)

STATE OF KANSAS

MAR 17 1953

CONSERVATION DIVISION
Wichita, Kansas

I hereby certify that the above information is true and correct to the best of my knowledge.

[Signature]

Subscribed and sworn to before me this 12 day of March, 1953.

[Signature]
Notary Public

My Commission Expires: 10-29-55

PLUGGING
FILE SEC. 23-24S-14W
BOOK PAGE 82 LINE 32