


STATE OF KANSAS  
STATE CORPORATION COMMISSION

Give All Information Completely  
Make Required Affidavit

Mail or Deliver Report to:  
Conservation Division  
State Corporation Commission  
800 Bittling Building  
Wichita, Kansas

WELL PLUGGING RECORD

NORTH

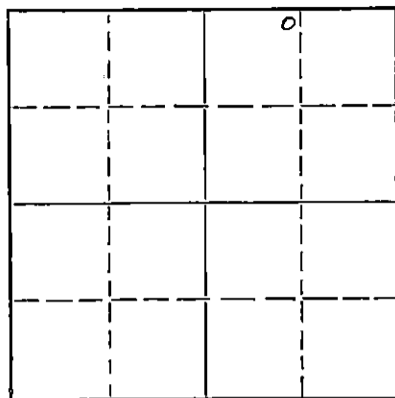

Locate well correctly on above  
Section Plat

Stafford County. Sec. 24 Twp. 24S Rge. 14 (E) W (W)  
Location as "NE/CNW/SW" or footage from lines NE NW NE  
Lease Owner Hilton Drilling Company, Inc.  
Lease Name Mason Well No. 1  
Office Address 2421 Tenth Street, Great Bend, Kansas  
Character of Well (completed as Oil, Gas or Dry Hole) dry hole  
Date well completed February 22 1954  
Application for plugging filed May 1 1954  
Application for plugging approved May 3 1954  
Plugging commenced May 5 1954  
Plugging completed May 9 1954  
Reason for abandonment of well or producing formation dry hole

If a producing well is abandoned, date of last production \_\_\_\_\_ 19\_\_\_\_  
Was permission obtained from the Conservation Division or its agents before plugging was commenced? yes

Name of Conservation Agent who supervised plugging of this well M. A. Rives  
Producing formation \_\_\_\_\_ Depth to top \_\_\_\_\_ Bottom \_\_\_\_\_ Total Depth of Well 4215 Feet  
Show depth and thickness of all water, oil and gas formations.

OIL, GAS OR WATER RECORDS

CASING RECORD

FORMATION	CONTENT	FROM	TO	SIZE	PUT IN	PULLED OUT
		0	203	8 5/8	203'	none
			4213	5 1/2	4213'	3100

Describe in detail the manner in which the well was plugged, indicating where the mud fluid was placed and the method or methods used in introducing it into the hole. If cement or other plugs were used, state the character of same and depth placed, from \_\_\_\_\_ feet to \_\_\_\_\_ feet for each plug set.

Filled hole with crushed to 3665'; dump 5 sx cement. Used pump truck to plug surface, mixed and pumped 25 sx gel mud put in plug, mixed and pumpen in 60 sx cement, shut well in, 150 psi standing.

(If additional description is necessary, use BACK of this sheet)

Name of Plugging Contractor Ace Pipe Pulling Co.  
Address Great Bend, Kansas

STATE OF KANSAS, COUNTY OF BARTON, ss.  
Henry Peacock, Secretary, (employee of owner) or (owner or operator) of the above-described well, being first duly sworn on oath, says: That I have knowledge of the facts, statements, and matters herein contained and the log of the above-described well as filed and that the same are true and correct. So help me God.

(Signature) Henry Peacock Secretary  
Great Bend, Kansas  
(Address)

SUBSCRIBED AND SWORN to before me this 12th day of May, 19 54

Margaret W. Whitman  
Notary Public.

My commission expires April 4, 1956.

24-7368-S 9-53-20M

**PLUGGING**  
FILE SEC 24 T 24 R 14W  
BOOK PAGE 31 LINE 18

**RECEIVED**  
STATE CORPORATION COMMISSION

5-15-54

CONSERVATION DIVISION  
Wichita, Kansas

DRILLER'S LOG

Company: Hilton Drilling Company, Inc. Location: NE NW NE  
 Contractor: Hilton Drilling Company, Inc. Section 24-24-14W  
 Farm Name: Mason #1 Elevation: 1936 DF  
 Commenced: 2-6-54  
 Completed: 2-22-54 Casing Used: 8-5/8 set @ 203' w/250 sacks  
 5-1/2 set @ 4213' w/150 sacks

Sand	68		
Yellow Clay	83		
Sand and shale	115		
Shale	240		
Red Bed	330		
Sand	365		
Red Bed, Shale and Shells	835		
Anhydrite	860		
Shale and Shells	970		
Shale & Shells, Salt	1410		
Shale & Shells	1556		
Shale & Lime	1668		
Lime & Shale	1730		
Lime	2185		
Sand	2200		
Lime & Shale	3240	Anhydrite	835 - 860
Lime	3470		1104-1079
Lime & Shale	3571	Heebner	3436 -1497
Lime	3868	Douglas	3474 -1535
Lime and Shale	3924	Brown Lime	3571 -1632
Conglomerate	3957	Lansing	3595 -1656
Lime, Shale & Chert	4044	Sooy Congl.	3918 -1979
Lime & Chert	4136	Kinderhook	3942 -2003
Lime, Shale & Sand	4165	Viola	4010 -2071
Arbuckle	4211	Simpson Sh.	4158 -2219
Lime	4215	Sand	4172 -2233
TOTAL DEPTH	4215	Arbuckle	4211 -2272

TOPS

STATE OF KANSAS )  
 ) ss.  
 COUNTY OF BARTON )

I, the undersigned, being duly sworn on oath, state that the above statement and log are true and a correct record and log of the well drilled at the location above described.

HILTON DRILLING COMPANY., INC.

*Henry Peacock*  
 Henry Peacock, Secretary

Subscribed and sworn to before me this 27 day of February, 1954.

*Margaret Whitmore*  
 Notary Public  
 STATE CORPORATE COMMISSION

My commission expires 4-4-56

MAR 25 1954

CONSERVATION DIVISION  
 Wichita, Kansas

PLUGGING  
 FILE SEC 24 T 24 R 14W  
 BOOK PAGE 31 LINE 18