


WELL PLUGGING RECORD

Give All Information Completely
Make Regular Affidavit
Mail or Deliver Report to:
Conservation Division
State Corporation Commission
800 Bittling Building
Wichita, Kansas

NORTH

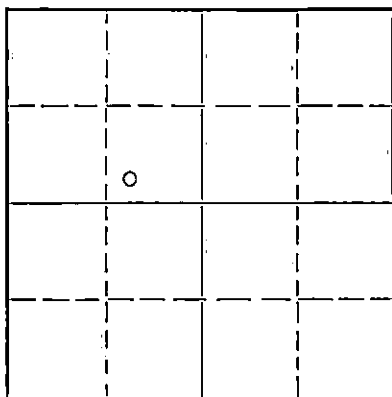

Locate well correctly on above
Section Plat

Stafford County. Sec. 24 Twp. 24 Rge. 14 (E) W (W)
Location as "NE/CNW $\frac{1}{4}$ SW $\frac{1}{4}$ " or footage from lines SW SE NW
Lease Owner White Eagle Oil Company
Lease Name Bridgens Well No. 1
Office Address First National Building, Tulsa, Oklahoma
Character of Well (completed as Oil, Gas or Dry Hole) dry hole
Date well completed May 22 1953
Application for plugging filed May 21 1953
Application for plugging approved May 22 1953
Plugging commenced May 22 1953
Plugging completed May 22 1953
Reason for abandonment of well or producing formation dry hole

If a producing well is abandoned, date of last production 19

Was permission obtained from the Conservation Division or its agents before plugging was commenced? yes

Name of Conservation Agent who supervised plugging of this well Rives

Producing formation Depth to top Bottom Total Depth of Well 4217 Feet

Show depth and thickness of all water, oil and gas formations.

OIL, GAS OR WATER RECORDS

CASING RECORD

Formation	Content	From	To	Size	Put In	Pulled Out
		0	248	8 5/8	248	none

Describe in detail the manner in which the well was plugged, indicating where the mud fluid was placed and the method or methods used in introducing it into the hole. If cement or other plugs were used, state the character of same and depth placed, from feet to feet for each plug set.

Filled hole with heavy rotary mud to from total depth to 240'. H.B. plug set at 240'. 20 sx cement and 1/2 sack hulls. Top plug at 35'. Filled hole w/10 sx cement H. B. Plug and 1/2 sack hulls to surface.

RECEIVED
STATE CORPORATION COMMISSION
MAY 28 1953
CONSERVATION DIVISION
Wichita, Kansas

(If additional description is necessary, use BACK of this sheet)
Name of Plugging Contractor Hilton Drilling Company, Inc.
Address P. O. Box 108, Great Bend, Kansas

STATE OF KANSAS, COUNTY OF BARTON, SS.
Henry Peacock (employee of owner) or (owner or operator) of the above-described well,

being first duly sworn on oath, says: That I have knowledge of the facts, statements, and matters herein contained and the log of the above-described well as filed and that the same are true and correct. So help me God.

(Signature) *Henry Peacock* Secretary
Great Bend, Kansas (Address)

SUBSCRIBED AND SWORN to before me this 25th day of May, 1953.

My commission expires April 4, 1956

Margaret Whitson Notary Public.

PLUGGING
FILE SEC 24 T 24 R 14 W
BOOK PAGE 103 LINE 18

D R I L L E R ' S L O G

COMPANY: WHITE EAGLE OIL COMPANY
 CONTRACTOR: HILTON DRILLING COMPANY, INC.
 FARM NAME: BRIDGENS NO. 1
 COMMENCED: May 5, 1953
 COMPLETED: May 22, 1953

LOCATION: SW SE NW 24-24-14
 Stafford County
 Kansas
 ELEVATION: 1937 D.F.

Casing Used: 8 5/8" set at 248' w/ 250 sacks

Sand	40
Sand and gravel	105
Shale and shells	220
Red Bed	250
Red Bed, shale, and shells	825
Anhydrite	850
Shale and shells	1010
Shale, shells, and salt	1330
Lime and shale	1475
Broken lime	1760
Lime	2250
Lime and shale	2990
Broken lime and shale	3100
Broken lime	3179
Lime and shale	3251
Lime	3477
Lime and shale	3591
Lime	3943
Shale and lime	3974
Conglomerate	4023
Viola Lime	4058
Chert and lime	4105
Viola Chert	4127
Lime and chert	4153
Shale, sand, and lime	4196
Shale and lime	4217
Total Depth	4217

STATE OF KANSAS)
) SS
 COUNTY OF BARTON)



 Wichita, Kansas

I, the undersigned, being duly sworn on oath, state that the above statement and log are true and a correct record and log of the well drilled at the location above described.

HILTON DRILLING COMPANY, INC.

Henry Peacock
 Henry Peacock, Secretary

Subscribed and sworn to before me this 25th day of May, 1953.

Margaret Whitman
 Notary Public

My commission expires April 4, 1956.

PLUGGING
 FILE SEC 24 T 24 R 14 W
 BOOK PAGE 108 LINE 18