

STATE OF KANSAS
STATE CORPORATION COMMISSION


WELL PLUGGING RECORD

Give All Information Completely
Make Required Affidavit
Mail or Deliver Report to:
Conservation Division
State Corporation Commission
800 Bitting Building
Wichita, Kansas

OR
FORMATION PLUGGING RECORD

Strike out upper line
when reporting plugging
of formations.

NORTH

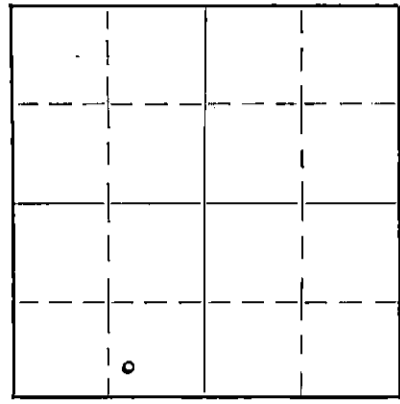

Locate well correctly on above
Section Plat

Reno County, Sec 1 Twp 25 Rge 4 (W)
Location as "NE 1/4 NW 1/4 SW 1/4" or footage from lines 330' N, 990' E of S 1/4 Corner
Lease Owner: Cities Service Oil Company
Lease Name: Haury Well No: 2-B
Office Address: Bartlesville, Okla.
Character of Well (Completed as Oil, Gas or Dry Hole): Oil Well
Date, well completed: Sept. 24, 1937
Application for plugging filed: July 3, 1939
Application for plugging approved: July 3, 1939
Plugging Commenced: July 3, 1939
Plugging Completed: July 9, 1939
Reason for abandonment of well or producing formation: Not commercial

If a producing well is abandoned, date of last production: June 25, 1939
Was permission obtained from the Conservation Division or its agents before plugging was commenced? Yes

Name of Conservation Agent who supervised plugging of this well: Ruel Durkee
Producing formation: Mississippi Lime Depth to top: 3266' Bottom: 3387' Total Depth of Well: 3387' Feet.
Show depth and thickness of all water, oil and gas formations.

OIL, GAS OR WATER RECORDS

CASING RECORD

Formation	Content	From	To	Size	Put In	Pulled Out
Mississippi Lime		3266'	3387'	10 1/2" W/270 Sr. 424'		0
				7" O.D. W/ 220 Sr	3347'	2390'
					plus screwage	

Describe in detail the manner in which the well was plugged, indicating where the mud fluid was placed and the method or methods used in introducing it into the hole. If cement or other plugs were used, state the character of same and depth placed, from _____ feet to _____ feet for each plug set.

Filled with mud 3387 to 3367', 10 sacks cement 3367 to 3327', mud and rock 3327 to 434', set wood plug at 434', 15 sacks cement 434 to 424', mud 424 to bottom of cellar, then 10 sacks cement at base of cellar

PLUGGING
FILE SEC-1-7-230 4W
BOOK PAGE 68 LINE 27

JUL 22 1939
7-22-39

(If additional description is necessary, use BACK of this sheet)

Correspondence regarding this well should be addressed to: R.C. Hauber
Address: Great Bend, Kansas

STATE OF Kansas COUNTY OF Barton, ss.
J.P. Gates (employee of owner) or (owner or operator) of the above-described well,

being first duly sworn on oath, says: That I have knowledge of the facts, statements, and matters herein contained and the log of the above-described well as filed and that the same are true and correct. So help me God.

(Signature) J.P. Gates
Chase Kansas
(Address)

SUBSCRIBED AND SWORN to before me this 19 day of July, 1939

My Commission Expires Sept. 26, 1942
My commission expires _____

Notary Public.

WELL RECORD

Company Cities Service Oil Co. No 2-B Farm Haury "B"Location 330' N - 990' E of S/4 Cor. Sec. 1 T. 23 R. 4-WElevation _____ County Reno State KansasDate Commenced: 9-1-37Date Completed 9-24-37 Initial Production 298 oil, 15% B. S., 24Drl. by E. J. Shaffer Drlg. Co. hrs. (after acid)

T. D. 3387'

Casing Record:

10-3/4" 424' cem. w/ 270 sxs.
7" 3347' cem. w/ 220 sxs.

Formation Record:

surface shale and sand	44
sand	106
sand & shells	227
sand & shale	300
hard sandy lime	417
shale & shells	780
sandy lime	994
broken lime	1540
shale & lime	1755
shale & lime shells	1940
shale & lime	2098
broken lime	2228
broken lime & lime shells	2260
lime	2335
broken lime	2400
lime	2629
lime sandy	2725
lime	2945
lime very hard	2991
lime	3235
shale	3250
variegated shale	3265
shale	3272
lime	3275
S.L.M. Corr.	3275=3270
Mississippi lime	3320
Miss. lime & shale	3330
Miss. lime	3350
S.L.M. Corr.	3350=3351
white chert (sat.)	3370
lime white w/ some chert	3387
Top Mississippi	3266
Penetration	121
Total Depth	3387

Acidized w/ 3000 gallons Dowell XX
September 27, 1937.

Summary at T.D. before acid
6 to 8 bbls. free oil per 24 hrs.
684 M. feet gas (gauge)

