


WELL PLUGGING RECORD

Give All Information Completely
Make Required Affidavit
Mail or Deliver Report to:
Conservation Division
State Corporation Commission
800 Bitting Building
Wichita, Kansas

Reno County, Sec. 1 Twp. 23 Rge. (E) 4 (W)

Location as "NE/CNW/SE" or footage from lines W/2 SE SE
Lease Owner Thos. H. Allan, et al
Lease Name Goering Well No. 1
Office Address 1221 Union National Bank Bldg., Wichita 2, Kansas
Character of Well (completed as Oil, Gas or Dry Hole) Oil Well
Date well completed March 3 1949
Application for plugging filed October 31 1953
Application for plugging approved November 2 1953
Plugging commenced November 9 1953
Plugging completed November 12 1953
Reason for abandonment of well or producing formation Exhausted

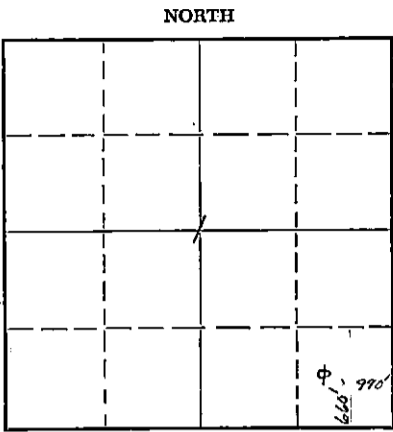

Locate well correctly on above Section Plat

If a producing well is abandoned, date of last production September 1953
Was permission obtained from the Conservation Division or its agents before plugging was commenced? Yes

Name of Conservation Agent who supervised plugging of this well Ruel Durkee
Producing formation Mississippi Depth to top 3288 Bottom ? Total Depth of Well 3357 Feet
Show depth and thickness of all water, oil and gas formations.

OIL, GAS OR WATER RECORDS

CASING RECORD

FORMATION	CONTENT	FROM	TO	SIZE	PUT IN	PULLED OUT
				8 5/8"	272'	None
				5 1/2"	3335'	2310 1/2'

Describe in detail the manner in which the well was plugged, indicating where the mud fluid was placed and the method or methods used in introducing it into the hole. If cement or other plugs were used, state the character of same and depth placed, from _____ feet to _____ feet for each plug set.

- 3357 - 3330 Crushed Rock
- 3330 - 3294 6 sacks cement
- 3294 - 285 Heavy Rotary mud
- 285 - 223 Bridge, crushed rock, & 15 sacks cement
- 223 - 30 Mud
- 30 - Surface Bridge, crushed rock, & 5 sacks cement

11-21-53

RECEIVED
STATE CORPORATION COMMISSION
WICHITA, KANSAS
NOV 21 1953
CONSERVATION DIVISION
WICHITA, KANSAS


(If additional description is necessary, use BACK of this sheet)
Name of Plugging Contractor Miller Casing Pulling Co.
Address Box 711, Great Bend, Kansas

STATE OF KANSAS, COUNTY OF SEDGWICK, ss.
Thos. H. Allan (employee of owner) or (owner or operator) of the above-described well, being first duly sworn on oath, says: That I have knowledge of the facts, statements, and matters herein contained and the log of the above-described well as filed and that the same are true and correct. So help me God.

(Signature) Thos. H. Allan
1221 Union National Bank Bldg., Wichita 2, Kansas
(Address)

SUBSCRIBED AND SWORN TO before me this 20th day of November 1953
Orin M. Stewart
Notary Public.

My commission expires June 14, 1954

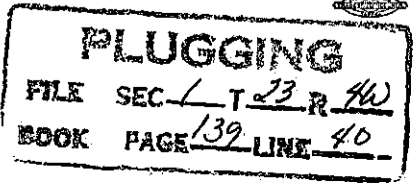

8 5/8" at 272' - 175 sx
5 1/2" at 3335' - 75 sx

Allan et al - #1 GOERING
W 1/2 SE SE 1-23-47
Burrton Pool, Reno County, Kansas
Comm: 1/22/49 Compl: 3/3/49
Contractor: Tom Allan
Elevation: 1487 Floor
I.P. Swab 15 bbl oil 3 water

15-155-61727-0000

0 - 200 surface sand
550 shale
500 salt & shale
2500 shale & shells
2550 shale & sand
2590 lime & shale
2620 porous oolitic lime
2640 shale
2660 lime
2675 shale
2725 lime
2740 shale
2760 oolitic lime
2785 shale
2800 porous oolitic lime
2820 lime
2900 shale & shells
2930 lime
2970 shale
2990 lime
3160 shale & shells
3180 shale
3288 lime
3292 dolomite
3305 lime
3325 cherty lime
3335 lime
3336 dolomite
Changed to Cable Tools
3341 dolomite - trace oil
3345 hard lime
3350 cherty lime
3356 dolomite - show oil
3357 chert - T. D.

FORMATION
3388 Top Mississippi Dolomite

Acid Treatment 1000 gal. 3335-41 &
1000 gal. 3350-56
Swab Test 5th day - 15 bbl oil 3 water

RECEIVED
STATE CORPORATION COMMISSION

OCT 3 1952

CONSERVATION DIVISION
Muskogee

PLUGGING
