


Give All Information Completely
Make Required Affidavit
Mail or Deliver Report to:
Conservation Division
State Corporation Commission,
800 Bittling Building
Wichita, Kansas

RECEIVED
WELL PLUGGING RECORD
OR
FORMATION PLUGGING RECORD
NOV 4 1936 11-4-36
Strike out upper line when reporting plugging of formations.
15-155-02751-0000

Reno County. Sec. 1 Twp. 23 Rge. (E) 4 (W)

Location as "NE $\frac{1}{4}$ NW $\frac{1}{4}$ SW $\frac{1}{4}$ " or footage from lines NE SW NE

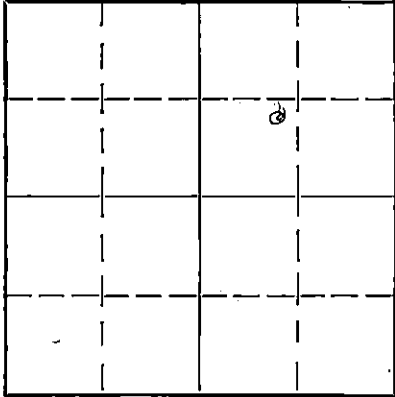

Locate well correctly on above Section Plat

Lease Owner.....
Lease Name Shell, Goering Well No. 1B
Office Address Union National Bank Building
Character of Well (Completed as Oil, Gas or Dry Hole) Dry Hole
Date, well completed 10/24/ 1936
Application for plugging filed 10/24 1936
Application for plugging approved 10/25 1936
Plugging Commenced 10/25 1936
Plugging Completed 10/25 1936
Reason for abandonment of well or producing formation Hole full water
If a producing well is abandoned, date of last production..... 1936
Was permission obtained from the Conservation Division or its agents before plugging was commenced?
Yes

Name of Conservation Agent who supervised plugging of this well G. D. Russell, McPherson, Kansas
Producing formation..... Depth to top..... Bottom..... Total Depth of Well 3355 Feet

Show depth and thickness of all water, oil and gas formations.


OIL, GAS OR WATER RECORDS

CASING RECORD

Formation	Content	From	To	Size	Put In	Pulled Out
				12 $\frac{1}{2}$ "	276	
				7"	3265	

Describe in detail the manner in which the well was plugged, indicating where the mud fluid was placed and the method or methods used in introducing it into the hole. If cement or other plugs were used, state the character of same and depth placed, from.....feet to.....feet for each plug set.

Mudded from 3355 to 3055'
Hole bridged & cemented at 3055 to 3025'
More mud from 3025 to 2725'
Hole bridged at 340 and cemented with
20' cement plug
Filled with mud to surface and capped
with cement.

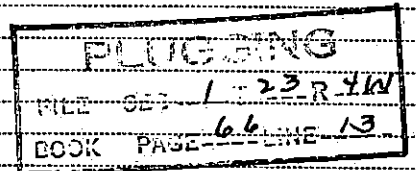

(If additional description is necessary use BACK of this sheet)

Correspondence regarding this well should be addressed to The Palmer Oil Corporation
Address 415 Union National Bank Building, Wichita, Kansas

STATE OF Kansas, COUNTY OF Sedgwick, ss.
Tom Buras (employee of owner) or (owner or operator) of the above-described well,

being first duly sworn on oath, says: That I have knowledge of the facts, statements, and matters herein contained and the log of the above-described well as filed and that the same are true and correct. So help me God.

(Signature) Tom Buras

Union National Bank Building, Wichita, Kansas
(Address)

SUBSCRIBED AND SWORN to before me this 2nd day of November, 1936

My commission expires March 1, 1939

M. E. Farrell
Notary Public.

TOM PALMER
 UNION NATIONAL BANK BUILDING
 WICHITA, KANSAS

15-155-02751-0000

CASING RECORD

RUN	Loss	Threads	LEFT IN HOLE	Location
20				HR 53 NW Sec. 1-23-47
15 1/2				Farm Shell, Corring #13
12 1/2	275' 7"		275' 7"	County Reno State Kansas
10				Contractor The Palmer Oil Corporation
8 1/4				Commence 9/22/36
6 5/8	3246' 6"		3246' 6"	Completed 10/25/36
5 3/16				Elevation 1461'

FORMATION	REMARKS	FEET OF STRATA	TOTAL DEPTH
Sand Shale		200	200
Sand	(Run 12" casing)	63	263
Shale & Shells		115	378
Shale & Salt, Lime		219	597
Lime		50	647
Shale & Lime		135	782
Shale, Sticky		90	872
Shale & Lime		75	947
Shale & Shells		15	962
Lime		15	977
Shale & Shells		115	1092
Lime		75	1167
Sticky Shale		35	1202
Shale		65	1267
Lime & Shale		75	1342
Shale & Shells		125	1467
Shale & Lime		75	1542
Shale		140	1682
Shale & Shells		85	1767
Broken Lime		55	1822
Shale		150	1972
Shale & Lime		60	2032
Lime		35	2067
Shale & Lime		30	2097
Lime		10	2107
Shale & Lime		75	2182
Lime		10	2192
Broken Lime		75	2267
Shale & Lime		75	2342
Lime		20	2362
Shale, Broken		35	2397
Shale & Lime		210	2607
Lime		75	2682
Shale		10	2692
Lime		30	2722
Lime		130	2852
Shale		15	2867
Lime		40	2907
Shale		100	3007
Shale & Lime Shells		45	3052
Shale		65	3117
Shale & Shells		65	3182
Shale		30	3212
Chat	(Run 6 5/8" casing)	7	3219
Chat, White, Soft	(Show of gas 3274-75')	72	3291
Chat, Hard	(Show of oil at 3337')	32	3323
Chat, White, Hard		29	3352
Chat, White, Soft		5	3357

PLUGGING



Dry Hole. Well plugged and abandoned.