

STATE OF KANSAS
STATE CORPORATION COMMISSION


WELL PLUGGING RECORD

Give All Information Completely
Make Required Affidavit
Mail or Deliver Report to:
Conservation Division
State Corporation Commission
800 Biting Building
Wichita, Kansas

OR
FORMATION PLUGGING RECORD

Strike out upper line
when reporting plug-
ging off formations.

Stafford County. Sec. 27 Twp 24S Rge 14 (W)
Location as "NE 1/4 NW 1/4 SW 1/4" or footage from lines. SE/4 NE/4 NW/4
Lease Owner. Central Supply Company
Lease Name. Fannie B. Neill Well No. 2
Office Address. P. O. Box 1777 - Tulsa, Oklahoma
Character of Well (completed as Oil, Gas or Dry Hole)
Date well completed. 10/6 19 44
Application for plugging filed. 12/21 19 49
Application for plugging approved. 12/22 19 49
Plugging commenced. 2/1 19 50
Plugging completed. 2/28 19 50
Reason for abandonment of well or producing formation. exhausted.

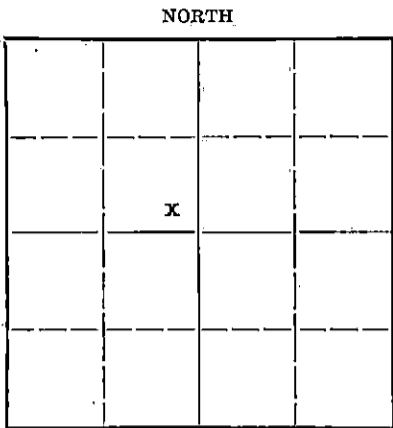

Locate well correctly on above
Section Plat

If a producing well is abandoned, date of last production. unknown 19
Was permission obtained from the Conservation Division or its agents before plugging was com-
menced? Yes

Name of Conservation Agent who supervised plugging of this well. Charlie Stough
Producing formation. Arbuckle Depth to top. 4209 Bottom. 4224 Total Depth of Well. 4224 Feet
Show depth and thickness of all water, oil and gas formations.

OIL, GAS OR WATER RECORDS

CASING RECORD

Formation	Content	From	To	Size	Put In	Pulled Out
				10-3/4	888'	none
				5 1/2	4210'	2458

Describe in detail the manner in which the well was plugged, indicating where the mud fluid was placed and the method or methods used in introducing it into the hold. If cement or other plugs were used, state the character of same and depth placed, from feet to feet for each plug set.

Plugged back to 4200' with Lane Well plug. Put five sacks of cement at 4200'. Shot pipe off at 2458, pulled pipe and filled with mud to 250'. Set rock bridge at 250' and 15 sacks cement. Mudded hole to 30' and put five sacks at top of surface pipe.

RECORDED
3-9-50
MAR 9 1950

(If additional description is necessary, use BACK of this sheet)

Correspondence regarding this well should be addressed to. Central Supply Company
Address. P. O. Box 1777 - Tulsa, Okla.

STATE OF OKLAHOMA, COUNTY OF TULSA, ss.
Sam Mizel partner

being first duly sworn on oath, says: That I have knowledge of the facts, statements, and matters herein contained and the log of the above-described well as filed and that the same are true and correct. So help me God.

(Signature) Sam Mizel
P.O. Box 1777 - Tulsa, Okla.
(Address)

Subscribed and sworn to before me this 8th day of March, 19 50

Inogen Hopper
Notary Public.

My commission expires October 8, 1951

PLUGGING
FILE SEC 27 T 24 R 14
BOOK PAGE 131 LINE 7