


WELL PLUGGING RECORD

Give All Information Completely  
Make Required Affidavit  
Mail or Deliver Report to:  
Conservation Division  
State Corporation Commission  
800 Bitting Building  
Wichita, Kansas

Harvey County, Sec. 18 Twp. 23 Rge. 3 (W)  
Location as "NE/CNW $\frac{1}{4}$ /SW $\frac{1}{4}$ " or footage from lines SE NE SE  
Lease Owner Simon Lebow  
Lease Name Martindell Well No. 4  
Office Address 608 Oil Capital Bldg., Tulsa, Okla.  
Character of Well (completed as Oil, Gas or Dry Hole) oil  
Date well completed 3-21-41 19  
Application for plugging filed 3-16-50 19  
Application for plugging approved 3-18-50 19  
Plugging commenced April 4 -50 19  
Plugging completed April 14-50 19  
Reason for abandonment of well or producing formation oil exhausted  
If a producing well is abandoned, date of last production 19  
Was permission obtained from the Conservation Division or its agents before plugging was commenced? yes

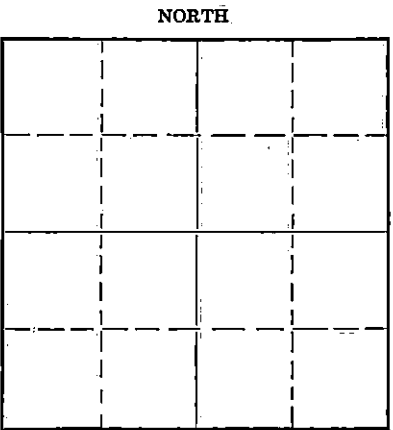

Locate well correctly on above Section Plat

Name of Conservation Agent who supervised plugging of this well Ruel Durkee  
Producing formation Depth to top Bottom Total Depth of Well Feet  
Show depth and thickness of all water, oil and gas formations.

OIL, GAS OR WATER RECORDS

CASING RECORD

Formation	Content	From	To	Size	Put In	Pulled Out

Describe in detail the manner in which the well was plugged, indicating where the mud fluid was placed and the method or methods used in introducing it into the hole. If cement or other plugs were used, state the character of same and depth placed, from feet to feet for each plug set.

Dumped 6 sacks of cement at 3260'. Shot pipe off at 2900'. Pulled pipe and mudded hole to 250'. Set rock bridge and dumped 15 sacks of cement at 250'. Finished mudding hole and put 10 sacks of cement at top of surface pipe.

4-22-50

*[Handwritten signature]*

APR 22 1950

ST.

(If additional description is necessary, use BACK of this sheet)

Correspondence regarding this well should be addressed to  
Address


STATE OF Oklahoma, COUNTY OF Tulsa, ss.  
Simon Lebow (employee of owner) or (owner or operator) of the above-described well, being first duly sworn on oath, says: That I have knowledge of the facts, statements, and matters herein contained and the log of the above-described well as filed and that the same are true and correct. So help me God.

(Signature) *[Signature]*  
608 Oil Capital Bldg., Tulsa, Okla.  
(Address)

SUBSCRIBED AND SWORN to before me this 21st day of April, 19 50

My commission expires 2-11-52

*[Signature]*  
Notary Public.

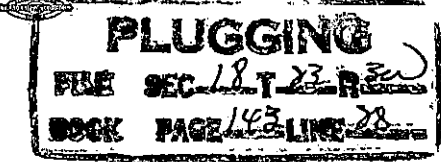


WELL LOG BUREAU - KANSAS GEOLOGICAL SOCIETY.  
412 Union National Bank Bldg, Wichita, Kansas.

CARL HIPPLE OIL COMPANY.  
Martindell No. 4

SEC. 18 T. 23 R. 3W.  
SE NE SE

Total Depth. 3362  
Comm. 2-18-41 Comp. 3-21-41  
Shot or Treated.  
Contractor. W.W.W. Drilling Co.  
Issued. 5-24-41

County Harvey

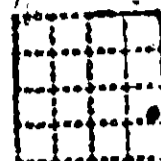

CASING.

10" 248'  
7" 3260'

Elevation.

Production. Pot. 150 B.

Figures Indicate Bottom of Formations.

surface	248	broken lime hard	2668
shale	410	shale	2675
shale & lime shells	600	broken shale & lime	2725
shale and lime	772	lime	2737
lime	800	lime hard	2762
lime and shale	873	broken lime	2793
lime broken	905	shale and lime	2825
red rock	920	shale	2845
shale	970	lime hard	2900
lime	988	shale	2910
lime and sand	1010	Kansas City lime	2912
red bed	1025	Broken lime & shale	2996
shale and lime	1088	shale and lime	3056
shale and lime-mostly lime	1178	lime	3103
lime	1210	lime and shale	3130
shale and lime	1245	conglomerate	3170
shale and lime shells	1380	lime and shale	3200
shale	1430	shale	3240
shale and shells	1560	broken lime and shale	
shale	1575	(hard lime)	3260
lime and shale	1927	Cable Tools.	
lime	1942	show gas	3263
shale	1992	Inc. gas	3276
lime and shale	2030	chat	3302
broken shale and lime	2130	chat hard	3310
lime	2140	chat show oil	3341
lime and shale	2205	chat Inc. oil	3362
broken lime and shale	2219	Total Depth.	
lime	2280		
shale	2300		
lime	2320		
broken lime	2369		
lime and shale	2447		
shale	2475		
lime (hard)	2516		
lime and flint	2525		
slate and shale	2536		
lime hard and shale	2596		
lime hard	2615		