

STATE OF KANSAS
STATE CORPORATION COMMISSION

Give All Information Completely
Make Required Affidavit
Mail or Deliver Report to:
Conservation Division
State Corporation Commission
212 No. Market
Wichita, Kansas 67202


WELL PLUGGING RECORD

Form CP-4

15-079-19050-0000

Harvey County, Sec. 18 Twp. 23S Rge. (E) 3 ¹/₄ (W)

Location as "NE/CNWxSWx" or footage from lines NW NW SE
Lease Owner Home-Stake Production Company
Lease Name Martindale W-49 Well No. W-49
Office Address Box 68, Burrton, Kansas 67020
Character of Well (completed as Oil, Gas or Dry Hole) input
Date well completed _____ 19____
Application for plugging filed June 23 1970
Application for plugging approved _____ 19____
Plugging commenced July 8 1970
Plugging completed July 10 1970
Reason for abandonment of well or producing formation no longer needed

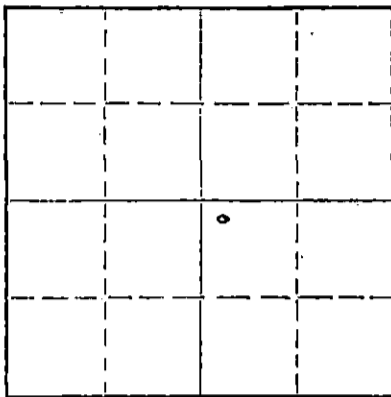

Locate well correctly on above Section Plat

If a producing well is abandoned, date of last production _____ 19____
Was permission obtained from the Conservation Division or its agents before plugging was commenced? yes

Name of Conservation Agent who supervised plugging of this well Hugh Scott
Producing formation _____ Depth to top _____ Bottom _____ Total Depth of Well 3371 Feet
Show depth and thickness of all water, oil and gas formations.

OIL, GAS OR WATER RECORDS

CASING RECORD

FORMATION	CONTENT	FROM	TO	SIZE	PUT IN	PULLED OUT
		0	508'	8 5/8"	508'	none
		0	3348'	4 1/2"	3348'	2511.50

Describe in detail the manner in which the well was plugged, indicating where the mud fluid was placed and the method or methods used in introducing it into the hole. If cement or other plugs were used, state the character of same and depth placed, from _____ feet to _____ feet for each plug set.

Sanded back to 3325' and dumped 4 sacks of cement.

Set 25' rock bridge at 225'. Plugged well with 3 yards of ready mix cement.

RECEIVED
STATE CORPORATION COMMISSION
JUL 24 1970
CONSERVATION DIVISION
Wichita, Kansas

(If additional description is necessary, use BACK of this sheet)
Name of Plugging Contractor Pipe Pullers, Inc.
Address Box 486, Ellinwood, Kansas

STATE OF KANSAS, COUNTY OF BARTON, ss.
Evelyn Roth (employee of owner) or (owner or operator) of the above-described well, being first duly sworn on oath, says: That I have knowledge of the facts, statements, and matters herein contained and the log of the above-described well as filed and that the same are true and correct. So help me God.

(Signature) Evelyn Roth
Ellinwood, Kansas (Address)

SUBSCRIBED AND SWORN TO before me this 20th day of July, 1970

My commission expires Feb. 10, 1971

George A Meyer
Notary Public.

HOME-STAKE PRODUCTION COMPANY
 REATOWER BUILDING
 TULSA, OKLAHOMA

WELL RECORD FOR
 WELLS IN KANSAS

15-079-19050-0000

Farm Name: Martindale Well Number: W-49

In the: Burrton Waterflood Project Character of Well: WATER INPUT

Located in: Harvey County, Kansas Section 18 Twn. 23S Range 3W

Well Spot: SE/4
60° East of West line, and 30° South of North line.

Ground Elevation: 1461' K. B. Elevation: 1466'

Drilling Started: January 27, 1964 NOTE: All measurements are from the K. B.

Drilling Completed: February 3, 1964 Well Completed: February, 1964

DATE OF FIRST PRODUCTION: - - DATE OF FIRST INJECTION: February 19, 1964

Casing Record: Set at 508' - 8-5/8", 28#, Smls, 8R, Used, surface casing.
Set at 3348' - 4-1/2", 9.5#, J55, Smls, 8R, New casing.

Cementing Record: 350 sacks regular cement w/2% Gel and 2% CC added for surf. casg.
150 sacks of common cement for the long string.
Cement was circulated.

Fracture or Shot Record: None

EFFECTIVE PAY ZONE: MISSISSIPPI (Tripolitic) CHAT

PERFORATED: <u>None - open hole.</u>	No. of Shots
	No. of Shots
	No. of Shots
	No. of Shots
	No. of Shots
	No. of Shots
	Total number of holes

FORMATION RECORD

Rotary drilled: Surface to 3371'

	Top	Bottom	Top	Bottom
Clay, sand and shale	-0-	230		
Shale and lime	230	508		
Lime	508	610		
Shale and shells	610	860		
Lime	860	925		
Lime and shale	925	1010		
Shale	1010	1185		
Shale and shells	1185	1460		
Shale and shells with lime streaks	1460	1755		
Shale and lime	1755	2005		
Lime w/shale streaks	2005	2145		
Shale and lime	2145	2518		
Lime beds with shale breaks	2518	3151		
Shaley lime	3151	3217		
Shale	3217	3259		
Mississippi Lime	3259	3344		
MISSISSIPPI CHAT	3344	3371		
			<u>Total Depth 3371'</u>	

RECEIVED
 STATE CORPORATION COMMISSION
 JUN 25 1970
 CONSERVATION DIVISION
 Wichita, Kansas

I, the undersigned, being first duly sworn upon oath, state that this well record is true, correct & complete according to our records and to the best of my belief and knowledge.

James C. Jones Vice Pres. Exploration
 Name and title of representative of company

Subscribed and sworn to before me this 20 day of March, 1964

My Commission expires 1-29-1967
James M. [Signature]
 Notary Public