


WELL PLUGGING RECORD

Give All Information Completely  
Make Required Affidavit  
Mail or Deliver Report to:  
Conservation Division  
State Corporation Commission  
800 Biting Building  
Wichita, Kansas

Harvey County. Sec. 31 Twp. 23S Rge. (E) 3 (W)  
Location as "NE/CNW/SW" or footage from lines NW NW NE  
Lease Owner Louis Kahan DBA Kahan Pipe & Supply Co.  
Lease Name J. G. Schrag Well No. 1  
Office Address P O Box 682, Tulsa, Okla.  
Character of Well (completed as Oil, Gas or Dry Hole) Oil  
Date well completed 11-5-38 19  
Application for plugging filed 9-9-56 19  
Application for plugging approved 9-11-56 19  
Plugging commenced Sept. 26 19 56  
Plugging completed Oct. 7 19 56  
Reason for abandonment of well or producing formation Depleted

NORTH

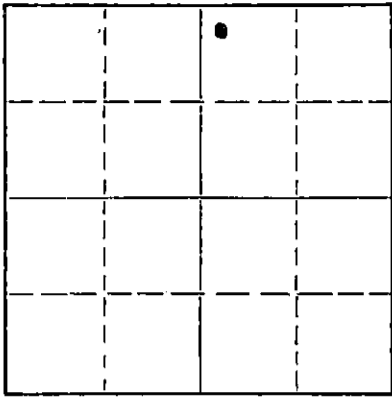

Locate well correctly on above Section Plat

If a producing well is abandoned, date of last production Aug 1954 19  
Was permission obtained from the Conservation Division or its agents before plugging was commenced? Yes

Name of Conservation Agent who supervised plugging of this well Ruel Durkee  
Producing formation 3274-3358 Depth to top Bottom Total Depth of Well 3358 Feet  
Show depth and thickness of all water, oil and gas formations.

OIL, GAS OR WATER RECORDS

CASING RECORD

FORMATION	CONTENT	FROM	TO	SIZE	PUT IN	PULLED OUT
Chat		3274	3358	7"	3275'	2510'

Describe in detail the manner in which the well was plugged, indicating where the mud fluid was placed and the method or methods used in introducing it into the hole. If cement or other plugs were used, state the character of same and depth placed, from feet to feet for each plug set.

Filled back with gravel to 3275'. Dumped 6 sacks of cement at 3275'. Shot pipe off at 2510'. Pulled pipe and mudded hole to 300'. Set rock bridge and dumped 40 sacks of cement at 300'. Finished mudding hole and dumped 10 sacks of cement at base of cellar.

(If additional description is necessary, use BACK of this sheet)

Name of Plugging Contractor Bert Self  
Address R.R. #1 Hutchinson, Kansas

STATE OF Kans., COUNTY OF Reno, ss.

Employee (employee of owner) or (owner or operator) of the above-described well, being first duly sworn on oath, says: That I have knowledge of the facts, statements, and matters herein contained and the log of the above-described well as filed and that the same are true and correct. So help me God.

(Signature)

R. R. #1, Hutchinson, Kans. (Address)

SUBSCRIBED AND SWORN to before me this 2nd day of Oct., 19 56

My commission expires

August 12, 1956

Notary Public.

PLUGGING  
FILE SEC 31 T. 23 R. 3W  
BOOK PAGE 97 LINE 41

RECEIVED  
OCT 24 1956  
CONSERVATION DIVISION  
Wichita, K.