


Give All Information Completely
Make Required Affidavit
Mail or Deliver Report to:
Conservation Division
State Corporation Commission
212 No. Market
Wichita, Kansas

WELL PLUGGING RECORD 15-155-02804-0000

Reno County, Sec. 12 Twp. 23S Rge. ~~XX~~ 4 (W)

Location as "NE/CNW/SW" or footage from lines NW/NW/SE
Lease Owner Sun Oil Company
Lease Name Teten Well No. 1
Office Address P. O. Box 729, Great Bend, Kansas 67530
Character of Well (completed as Oil, Gas or Dry Hole) Oil
Date well completed 10-16 1937
Application for plugging filed 11-23 1970
Application for plugging approved 11-24 1970
Plugging commenced 12-14 1970
Plugging completed 12-16 1970
Reason for abandonment of well or producing formation Depleted

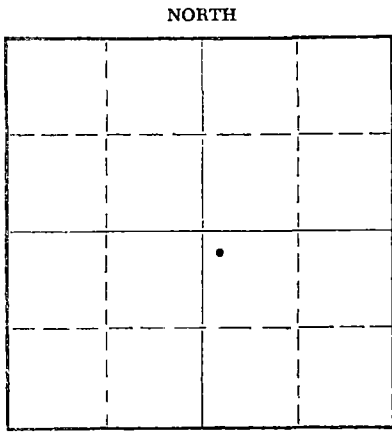

Locate well correctly on above Section Plat

If a producing well is abandoned, date of last production September 1965
Was permission obtained from the Conservation Division or its agents before plugging was commenced? Yes

Name of Conservation Agent who supervised plugging of this well Mr. Gilbert Toman
Producing formation Hunton Depth to top 3607' Bottom 3608' Total Depth of Well 3608' Feet
Show depth and thickness of all water, oil and gas formations.

OIL, GAS OR WATER RECORDS

CASING RECORD

FORMATION	CONTENT	FROM	TO	SIZE	PUT IN	PULLED OUT
		0	491'	12-1/2"	491'	0
		0	3410'	7"	3410'	2527'
		3281'	3608'	4-1/2"	325'	0

Describe in detail the manner in which the well was plugged, indicating where the mud fluid was placed and the method or methods used in introducing it into the hole. If cement or other plugs were used, state the character of same and depth placed, from _____ feet to _____ feet for each plug set.

Made bottom hole plug back with sand to 3250'. Mixed and ran 6 sacks cement through dump bailer. Mudded hole to 215', set 15' rock bridge. Filled hole with 6 yards ready-mix to base of cellar.

RECEIVED
STATE CORPORATION COMMISSION
DEC 30 1970
CONSERVATION DIVISION
Wichita, Kansas

(If additional description is necessary, use BACK of this sheet)

Name of Plugging Contractor Southwest Casing Pulling Company
Address P. O. Box 364, Great Bend, Kansas 67530

STATE OF KANSAS, COUNTY OF BARTON, ss.
C. M. Graham (employee of owner) or (owner or operator) of the above-described

well, being first duly sworn on oath, says: That I have knowledge of the facts, statements, and matters herein contained and the log of the above-described well as filed and that the same are true and correct. So help me God.

(Signature) C. M. Graham C. M. Graham
P. O. Box 729, Great Bend, Kansas 67530
(Address)

SUBSCRIBED AND SWORN TO before me this 29th day of December, 1970

Peggy H. Olivan
Peggy H. Olivan
Notary Public.

My commission expires January 12, 1974

SUNRAY OIL COMPANY
WELL COMPLETION RECORD

WELL No. 1

15-155-02804-0000

LEASE Teten Lease

320

WELL LOG

DISTANCE FROM POINT OF MEASUREMENT TO TOP OF BRADENHEAD FLANGE

FORMATION	FROM	TO	FORMATION	FROM
Sand & Clay		353		
Shale & Shells	133	491	Set 12 $\frac{1}{2}$ " at 391' Cemented w/ 400 Sacks of Cement.	
Shale & Shells	39	530		
Shale & Shells	135	765		
Shale & Lime	330	1095		
Shale & Lime	205	1300		
Shale & Shells	300	1600		
Shale & Lime	150	1750		
Shale & Shells	120	1870		
Shale & Lime	160	2030		
Shale & Shells	135	2165		
Shale & Lime	95	2260		
Shale & Lime	120	2380		
Shale & Lime	30	2410		
Sand	30	2490		
Shale & Shells	50	2540		
Lime	35	2625		
Lime	100	2725		
Lime	6	2731		
Soft Lime	7	2738		
Hard Lime	42	2780		
Lime	35	2815		
Lime	55	2870		
Soft Lime	33	2903		
Lime	7	2915		
Lime	20	2935		
Lime	40	2975		
Lime	75	3050		
Shale & Lime Broken	55	3105		
Lime & Shale	60	3165		
Shale	50	3215		
Shale	44	3259		
Lime	12	3271		
Chat	34	3305		
Chat	35	3340		
Chat & Lime	43	3338		
Chat & Lime	22	3410		
			Top of Miss. Lime.	
			Total depth	

RECEIVED
STATE CORPORATION COMMISSION
NOV 24 1970
CONSERVATION DIVISION
Wichita, Kansas