


Give All Information Completely
Make Required Affidavit
Mail or Deliver Report to:
Conservation Division
State Corporation Commission
212 No. Market
Wichita, Kansas

WELL PLUGGING RECORD 15-155-20107-0000

Reno County, Sec. 23 Twp. 23 Rge. 4 (E) (W)

Location as "NE/CNW/SW" or footage from lines NE SE SW NE
Lease Owner R. L. Evans
Lease Name Evans #9 Well No. _____
Office Address Hutchinson, Kansas 67501
Character of Well (completed as Oil, Gas or Dry Hole) _____
Date well completed _____ 19____
Application for plugging filed _____ 19____
Application for plugging approved _____ 19____
Plugging commenced 8/21/69 _____ 19____
Plugging completed 8/29/69 _____ 19____
Reason for abandonment of well or producing formation depleted.

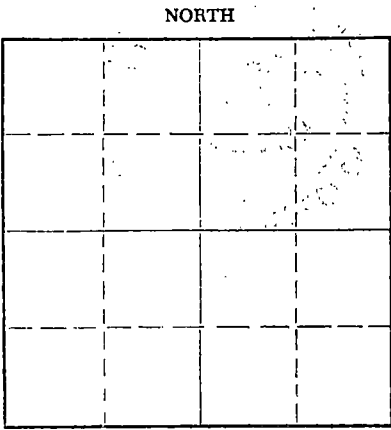

Locate well correctly on above Section Plat

If a producing well is abandoned, date of last production _____ 19____
Was permission obtained from the Conservation Division or its agents before plugging was commenced? yes
Scott

Name of Conservation Agent who supervised plugging of this well _____
Producing formation _____ Depth to top _____ Bottom _____ Total Depth of Well 3360 Feet
Show depth and thickness of all water, oil and gas formations.

OIL, GAS OR WATER RECORDS

CASING RECORD

FORMATION	CONTENT	FROM	TO	SIZE	PUT IN	PULLED OUT
				10-3/4	256	none
				8-5/8	555	332'
				5 1/2"	3221	2757'

Describe in detail the manner in which the well was plugged, indicating where the mud fluid was placed and the method or methods used in introducing it into the hole. If cement or other plugs were used, state the character of same and depth placed, from _____ feet to _____ feet for each plug set.

Checked bottom, ran sand to 3200' and dumped 5 sacks of cement. Loaded hole, shot pipe at 2766', pulled 86 joints. Had welder cut off 10", weld on 8-5/8" collar, rigged up on 8-5/8", shot pipe at 426', 331', pulled 11 joints of 8-5/8". Had welder cut and weld on collars. Bailed hole to 270', 10' rock bridge and dumped 35 sacks of cement. Mudded to 40', 10' rock bridge and dumped 15 sacks of cement. Tallied pipe.

PLUGGING COMPLETE.

RECEIVED
STATE CORPORATION COMMISSION
SEP 30 1969
CONSERVATION DIVISION
Wichita, Kansas

(If additional description is necessary, use BACK of this sheet)
Name of Plugging Contractor KNIGHT CASING PULLING CO., INC.
Address CHASE, KANSAS


STATE OF KANSAS COUNTY OF RICE, ss.
NOEL J. KNIGHT (employee of owner) or (owner or operator) of the above-described well, being first duly sworn on oath, says: That I have knowledge of the facts, statements, and matters herein contained and the log of the above-described well as filed and that the same are true and correct. So help me God.

(Signature) Noel Knight
CHASE, KANSAS
(Address)

Subscribed AND Sworn to before me this 2nd day of September, 19 69

My commission expires 2/15/71

Margaret Melcher
Notary Public.

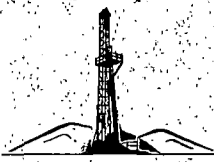

RP

Blackstone Drilling, Inc.

Box 455 • 523 West Kansas • Phone CH 1-1250

McPHERSON • KANSAS
67460

April 15, 1969

15-155-20107-0000

COMPANY: R. L. EVANS
 CONTRACTOR: BLACKSTONE DRILLING, INC.
 FARM: EVANS #9
 LOCATION: SE/4 SW/4 NE/4, Sec. 23-23-4W,
 Reno County, Kansas
 COMMENCED: April 8, 1969
 COMPLETED: April 15, 1969
 ELEVATION:

0	to	205	Sand
205	to	253	Blue Shale
253	to	430	Shale
430	to	552	Dry Drilled
552	to	830	Shale & Lime
830	to	1340	Lime & Shale
1340	to	2085	Shale & Lime
2085	to	3050	Lime
3050	to	3200	Lime & Shale
3200	to	3265	Shale & Lime
3265	to	3320	Mississippi
		3320	T. D.

RECEIVED
 STATE CORPORATION COMMISSION
 AUG 21 1969
 CONSERVATION DIVISION
 Wichita, Kansas

Cut 15 1/4 in. hole to 253 ft. and run 256 ft. of 10 3/4 in. surface pipe and cemented on bottom at 253 with 225 sacks cement. Plug down at 4:00 P.M., April 8, 1969. Cut 9 7/8 in hole from 253 ft. to 555 ft. and run 555 ft. of 8 5/8 in. surface pipe, cemented with 100 sacks on bottom at 552 ft. Plug down at 3:30 P.M., April 9, 1969. Cut 7 7/8 in. hole to 3320 ft. and run 3321 ft. of 5 1/2 in. O.D. casing, set 2 foot off bottom at 3318 ft. with 75 sacks salt saturated pozmix. Plug down at 11:00 P.M., April 15, 1969.

TOPS: Mississippi - 3265'

Measurements taken from K.B.

CERTIFICATE

I, H. J. Plouffe, President of Blackstone Drilling, Inc. do hereby certify that the above and foregoing is a true and correct copy of log on your Evans #9, located on the SE SW NE, Sec. 23-23-4W, Reno County, Kansas as reflected by the files of Blackstone Drilling, Inc.

H. J. Plouffe
 H. J. Plouffe, President

Subscribed and sworn to before me a Notary Public in and for McPherson County, Kansas this 16th day of April, 1969.

Ruth McVay
 Ruth McVay - Notary Public



Commission Expires: December 18, 1969.