

STATE OF KANSAS  
STATE CORPORATION COMMISSION


WELL PLUGGING RECORD  
OR  
FORMATION PLUGGING RECORD

Strike out upper line when reporting plugging of formations.

Give All Information Completely  
Make Required Affidavit  
Mail or Deliver Report to:  
Conservation Division  
State Corporation Commission,  
800 Bitting Building,  
Wichita, Kansas

RENO County. Sec. 23 Twp. 23 Rge. (E) 4 (W)

Location as "NE 1/4 NW 1/4 SW 1/4" or footage from lines SE NE NW  
Lease Owner THE OHIO OIL COMPANY  
Lease Name S. E. VANSICKLE Well No. 4  
Office Address Box 710, McPherson, Kansas  
Character of Well (Completed as Oil, Gas or Dry Hole) Oil  
Date, well completed March 29 1935  
Application for plugging filed June 1 1935  
Application for plugging approved June 4 1935  
Plugging Commenced June 13, 1935  
Plugging Completed July 1, 1935  
Reason for abandonment of well or producing formation Depleted

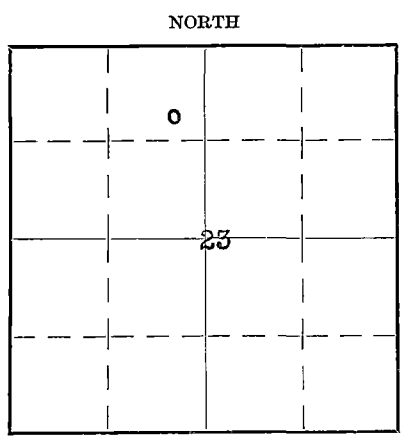

Locate well correctly on above Section Plat


If a producing well is abandoned, date of last production May 4 1935  
Was permission obtained from the Conservation Division or its agents before plugging was commenced? Yes

Name of Conservation Agent who supervised plugging of this well Mr. Ruel Durkee  
Producing formation Hunton (orig.) PB to Chat Depth to top 3240 Bottom 3353 Total Depth of Well PB 3512 Feet  
Show depth and thickness of all water, oil and gas formations.

Formation	Content	From	To	Size	Put In	Pulled Out
Chat	Oil	3240	3353	15 1/2"	237	None
Hunton	Oil	3587	3605	12 1/2"	778	306' 8"
PB from Hunton to Chat in June, 1940				7"	3587	2463' 10"

Describe in detail the manner in which the well was plugged, indicating where the mud fluid was placed and the method or methods used in introducing it into the hole. If cement or other plugs were used, state the character of same and depth placed, from \_\_\_\_\_ feet to \_\_\_\_\_ feet for each plug set.

Mudded hole with heavy mud from TD to 3200'. Ran 6 sacks cement plug from 3200 to 3170'. Shot pipe loose at 2460' and mudded hole to 800' with heavy mud. Shot 12 1/2" pipe loose at 310'. Mudded hole to 255' w/ heavy mud, placed rock bridge from 255' to 245', bailed hole to bridge and ran 40 sacks, cement plug from 245' to 210'. Mudded hole to 10' and ran 10 sacks cement to fill to surface.

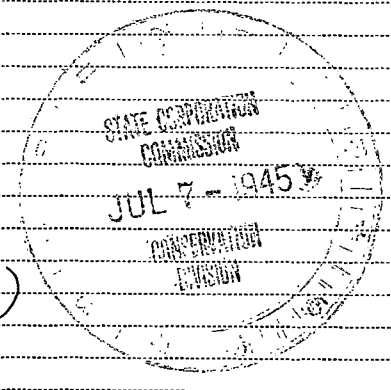

PLUGGING  
23 23 40  
15 1/2 12

(If additional description is necessary use BACK of this sheet)  
Correspondence regarding this well should be addressed to THE OHIO OIL COMPANY  
Address BOX 710, MCPHERSON, KANSAS

STATE OF KANSAS, COUNTY OF MCPHERSON, ss.  
FRED V. KLUCK (employee of owner) or (owner or operator) of the above-described well,

being first duly sworn on oath, says: That I have knowledge of the facts, statements, and matters herein contained and the log of the above-described well as filed and that the same are true and correct. So help me God.

(Signature) Fred V. Kluck  
BOX 710 McPherson, Kansas  
(Address)

SUBSCRIBED AND SWORN to before me this 6th day of July, 1945

My Commission Expires Nov. 13, 1948  
My commission expires \_\_\_\_\_  
Notary Public.

THE OHIO OIL COMPANY  
S. E. VANSICKLE NO. 4  
990 NL; 330 EL; Sec 23-23S-4W.

Drilled by Patton Drilling Co.  
Commenced Feb. 20, 1935  
Completed Mar. 29, 1935

15-155-02565-0000

Rotary tools.

Complete sample log not available

Mississippi Chat 3240 to 3353	15 $\frac{1}{2}$ " csg. cem. at 237' w/ 250 sx.
Hunton Lime 3587 to 3605	12 $\frac{1}{2}$ " csg. cem. at 778' w/ 100 sx.
Total Depth 3605	6 5/8" cem. at 3587 w/ 600 sx.

Acidized 1000 gal in Hunton upon completion.  
Produced 1086 bbl. per day before acidized; 2191 bbl. per day after acid.

PB and Perforated in Chat formation on June 16, 1940

Plugged back w/ 128 sx. cement to 3512'  
Gun perforated w/ 100 shots from 3265 to 3370'  
Acidized w/ 1000 gal.  
Pumped 40 bbl. oil 10 bbl. water on state test 6/24/40

March 1942, cleaned out well to 3532.  
Gun perforated 66 holes 3345' to 3370'  
Acidized w/ 1500 gal.  
Raised oil production from 2 to 6 $\frac{1}{2}$  bbl. per day

May, 1945  
Well depleted of oil.

