

STATE OF KANSAS
STATE CORPORATION COMMISSION

WELL PLUGGING RECORD


Give All Information Completely
Make Required Affidavit
Mail or Deliver Report to:
Conservation Division
State Corporation Commission
800 Biting Building
Wichita, Kansas

OR
~~FORMATION PLUGGING RECORD~~

Strike out upper line
when reporting plug-
ging off formations.

RENO County, Sec. 23 Twp. 23S Rge. 4 (E) W (W)

Location as "NE $\frac{1}{4}$ NW $\frac{1}{4}$ SW $\frac{1}{4}$ " or footage from lines NW SE SW
Lease Owner Olson Drilling Company
Lease Name M. B. Blake Well No. 5
Office Address PO Box 2680 Tulsa 1 Oklahoma
Character of Well (completed as Oil, Gas or Dry Hole) ~~Oil~~ Oil
Date well completed 3-8-35 19
Application for plugging filed Dec. 7th 1944 19
Application for plugging approved Dec. 8th 1944 19
Plugging commenced Jan. 12th 1945 19
Plugging completed Jan. 19th 1945 19
Reason for abandonment of well or producing formation Dry Hole
If a producing well is abandoned, date of last production June 1943 19
Was permission obtained from the Conservation Division or its agents before plugging was com-
menced? Yes

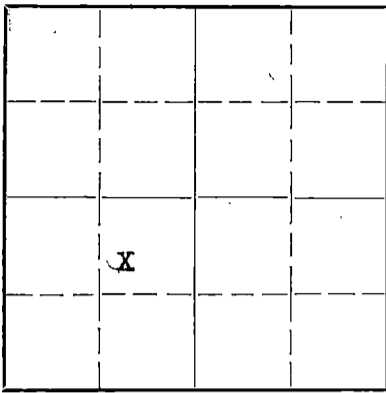

Locate well correctly on above
Section Plat

Name of Conservation Agent who supervised plugging of this well Mr. Durkee
Producing formation Lime Depth to top 323590 Bottom 3614 Total Depth of Well 3614 Feet
Show depth and thickness of all water, oil and gas formations.


OIL, GAS OR WATER RECORDS

CASING RECORD

Formation	Content	From	To	Size	Put In	Pulled Out
				15 1/2"	262'	none
				12 1/2"	510'	173.25
				7"	3590'	1005'35

Describe in detail the manner in which the well was plugged, indicating where the mud fluid was placed and the method or methods used in introducing it into the hold. If cement or other plugs were used, state the character of same and depth placed, from _____ feet to _____ feet for each plug set.

Filled Hole with Mud from bottom up to 250' & run 30 Sk. Cement
Filled with mud to 5' Run 10 Sk. cement in Base of cellar.

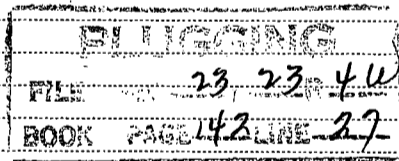

(If additional description is necessary, use BACK of this sheet)

Correspondence regarding this well should be addressed to Olson Drilling Company
Address PO Box 2680 Tulsa 1 Oklahoma

STATE OF KANSAS, COUNTY OF RENO
S.A. Keefover (employee of owner) or (owner or operator) of the above-described well,
being first duly sworn on oath, says: That I have knowledge of the facts, statements, and matters herein contained and the log of the above-described well as filed and that the same are true and correct. So help me God.

(Signature) S.A. Keefover
Rt. 1 Burrton., Kansas (Address) 1-22-44

SUBSCRIBED AND SWORN TO before me this 20th day of January, 19 45

My commission expires June 19th 1948

E. J. Beard
Notary Public.



15-155-02554-0000

OLSON OIL COMPANY
M. B. BLAKE # 5
990' fr EL, 860' fr, SL
NW SE SW SW¹/₄, 23-23s-4W
RENO COUNTY, KANSAS.

COMMENCED 1-19-35
COMPLETED 3-8-35
ELEVATION 1471'

- 0
- 121--Sand
- 262--Sand & shale
- 920--Shale & lime shells
- 994--Lime & shale
- 1020--Broken Lime
- 1268--Shale & lime shells
- 1347--Shale
- 1859--Shale & lime shells
- 1959--Shale & lime
- 2095--Broken lime
- 2187--Lime & shale
- 23030--Broken lime
- 40--Shale
- 58--Lime
- 2430--Broken lime
- 45--Lime
- 75--Shale & lime shells
- 2505--Sandy shale
- 25--Shale & lime
- 70--Broken lime
- 2660--Lime
- 89--Lime & shale
- 2847--Broken lime
- 2815--Lime
- 43--Shale & lime shells
- 80--Sandy lime
- 3019--Lime
- 82--Broken Lime
- 3155--Shale & lime
- 3223--Shale & lime shells
- 56--Shale
- 3411--Chat
- 40--Chat & lime
- 91--Lime
- 3580--Shale
- 99--Lime, r.u.s.t.
- 3614--Lime
- T.D.

CASING RECORD

15 ¹ / ₂ "	70#	262'
12 ¹ / ₂ "	50#	510'
7"	22#	3590'

23 23 4W
142 27

