


STATE OF KANSAS
 STATE CORPORATION COMMISSION
 Give All Information Completely
 Make Required Affidavit
 Mail of Deliver Report to:
 Conservation Division
 State Corporation Commission
 212 North Market, Insurance Bldg.
 Wichita, Kansas

15-095-00373-0001

WELL PLUGGING RECORD

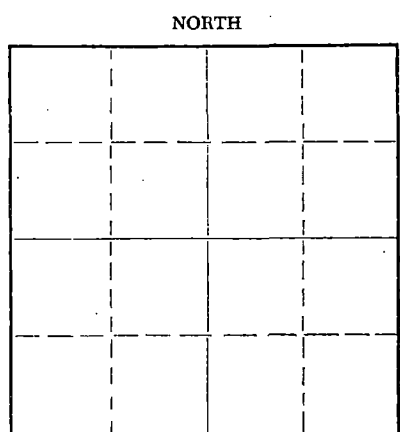

Locate well correctly on above Section Plat

Location as "NE/CNW/SW" or footage from lines Kingman County. Sec. 3 Twp 27 Rge. 10 (E) W (W)
 NE NE SW
 Lease Owner XXXXXX Aylward Drilling Co.
 Lease Name Tonn #1 Well No. _____
 Office Address Wichita, Kansas
 Character of Well (completed as Oil, Gas or Dry Hole) Dry
 Date well completed _____ 19____
 Application for plugging filed May 20 1959
 Application for plugging approved " 20 1959
 Plugging commenced 5-21-59 19____
 Plugging completed 5-25-59 19____
 Reason for abandonment of well or producing formation _____

If a producing well is abandoned, date of last production _____ 19____
 Was permission obtained from the Conservation Division or its agents before plugging was commenced? yes

Name of Conservation Agent who supervised plugging of this well Fred Hampel
 Producing formation _____ Depth to top _____ Bottom _____ Total Depth of Well 4562 Feet
 Show depth and thickness of all water, oil and gas formations.

OIL, GAS OR WATER RECORDS

CASING RECORD

FORMATION	CONTENT	FROM	TO	SIZE	PUT IN	PULLED OUT
				8-5/8"	262'	none
				5-1/2"	4206'	3675'

Describe in detail the manner in which the well was plugged, indicating where the mud fluid was placed and the method or methods used in introducing it into the hole. If cement or other plugs were used, state the character of same and depth placed, from _____ feet to _____ feet for each plug set.

Checked the hole to 4170' and found it open.
 Filled w/sand to 4000' and dumped 5 sacks of cement with bailer. Pulled 5 1/2" casing, cleared hole and bailed the hole to 240', set rock bridge to 230' and dumped 20 sacks of cement. Mudded the hole to 35', set rock bridge and ran 10 sacks of cement to base of cellar.

PLUGGING COMPLETED

RECEIVED
 STATE CORPORATION COMMISSION
 AUG 21 1959
 CONSERVATION DIVISION
 Wichita, Kansas

(If additional description is necessary, use BACK of this sheet)
 Name of Plugging Contractor West Supply Co., Inc.
 Address Chase, Kansas

STATE OF KANSAS COUNTY OF RICE, ss.
I, Noel J. Knight (employee of owner) or (~~owner of interest~~) of the above-described well, being first duly sworn on oath, says: That I have knowledge of the facts, statements, and matters herein contained and the log of the above-described well as filed and that the same are true and correct. So help me God.
 (Signature) Noel J. Knight
Chase, Kansas (Address)

SUBSCRIBED AND SWORN to before me this 28th day of May, 19 59

Thomas V. Duggo
 Notary Public.

My commission expires 9-27-62

PLUGGING
 FILE SEC 3 T. 27 R. 10
 BOOK PAGE 40 LINE 2

15-095-00373-0000

TONN NO. 1

Casing Record:

8 5/8" - 262'
5 1/2" - 4208'

Company: Aylward Drilling Company
Contractor: Aylward Drilling Company

Commenced: April 23, 1959
Completed: May 6, 1959

Location: SW SW NE 3-27-10W
Kingman County
Kansas

Elevation: 1742 R.B.

	<u>From</u>	<u>To</u>	<u>Remarks</u>
Sand	0	90	Set 8 5/8" surface pipe @ 262' w/225 sax cement.
Water sand	90	160	
Sandy Red rock	160	210	Geological Tops: Heebner 3373 Toronto 3384 Douglas 3391 Brown Lime 3537 Lansing 3548 B/KC 3924 Miss. 4041 Kinderhook 4101 Viola 4307 Simpson 4382 Arbuckle 4470 R.T.D. 4500 DST 4042-65 Open 1 hr. Rec. 15' SI.GCMdySW IBHP 620#/20" - FBHP 110#/30" FP 0#-0#. 5 1/2" @ 4208' w/75 sax cement.
Red Bed	210	262	
Red rock	262	450	
Red bed & shells	450	490	
Red bed & blue shale	490	1120	
Salt, shale & shells	1120	1390	
Shale & shells	1390	1460	
Lime & shale	1460	1600	
Lime w/shale	1600	1740	
Lime & shale	1740	2190	
Shale & lime	2190	2360	
Shale w/some lime	2360	2575	
Shale & lime	2575	2630	
Sand & shale	2630	2650	
Shale & lime	2650	2703	
Lime & shale	2703	2869	
Sandy lime & shale	2869	3165	
Shale & lime	3165	3275	
Lime & shale	3275	3400	
Shale & lime	3400	3495	
Sandy shale & lime	3495	3534	
Lime	3534	3920	
Lime & shale	3920	4034	
Lime & chert	4034	4065	
Chert	4065	4103	
Shale	4103	4106	
Lime & shale	4106	4215	
Shale & lime	4215	4305	
Lime & chert	4305	4325	
Cherty lime	4325	4380	
Shale	4380	4402	
Shale & sandy lime	4402	4440	
Shale & lime	4440	4482	
Lime	4482	4500 T.D.	

I hereby certify that this is a true and correct copy of the above log to the best of my knowledge.

Subscribed and sworn to before me this 14th day of May 1959.

My commission expires December 11, 1961

Paul W. Jessup
Duane Jessup
 DUANE JESSUP Notary Public

PLUGGING
 FILE SEC. 3 T. 27 R. 10W
 BOOK PAGE 40 LINE 2