

WELL PLUGGING RECORD


OR FORMATION PLUGGING RECORD

Strike out upper line when reporting plugging of formations.

STATE OF KANSAS STATE CORPORATION COMMISSION

Give All Information Completely Make Required Affidavit Mail or Deliver Report to: Conservation Division State Corporation Commission 800 Bittling Building Wichita, Kansas

Kingman County. Sec. 11 Twp. 27S Rge. (E) 10 (W) Location as "NE 1/4 NW 1/4 SW 1/4" or footage from lines SW - SW - SW Lease Owner: Joel Shannon Lease Name: Joel Well No. #1 Office Address: Character of Well (Completed as Oil, Gas or Dry Hole): Dry Hole Date, well completed: Feby 13, 1939 Application for plugging filed: April 28, 1939 Application for plugging approved: April 29, 1939, Received: May 1, 1939 Plugging Commenced: May 8, 1939 Plugging Completed: may 24, 1939 Reason for abandonment of well or producing formation: Well Dry

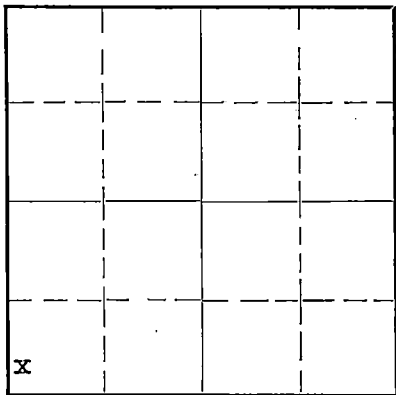

Locate well correctly on above Section Plat

Name of Conservation Agent who supervised plugging of this well: Guy Wershing, Lyons, Kansas. Producing formation: Depth to top: 3331 Bottom: Total Depth of Well: 3581 Feet. Show depth and thickness of all water, oil and gas formations.

OIL, GAS OR WATER RECORDS


CASING RECORD

Table with 7 columns: Formation, Content, From, To, Size, Put In, Pulled Out. The table is currently empty.

Describe in detail the manner in which the well was plugged, indicating where the mud fluid was placed and the method or methods used in introducing it into the hole. If cement or other plugs were used, state the character of same and depth placed, from feet to feet for each plug set.

Mud to 3500 ft and cement to 3485, Mud to 260 ft., 5 ft rock and 15 ft of cement to 240 ft, mud to 10 ft and capped with 8 sacks of cement.

PLUGGING FILE SEC 11-T 27-R-10W BOOK PAGE 60 LINE 14

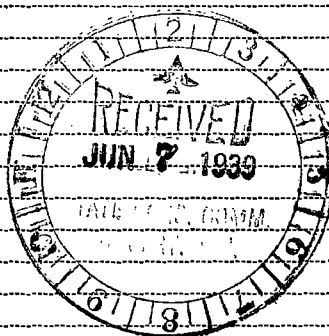

(If additional description is necessary, use BACK of this sheet)

Correspondence regarding this well should be addressed to: Jock Garden Contracting Co, Address: 504 Wolcott Bldg., Hutchinson, Kansas.

STATE OF Kansas, COUNTY OF Reno, ss. Jock Garden (employee of owner) or (owner or operator) of the above-described well,

being first duly sworn on oath, says: That I have knowledge of the facts, statements, and matters herein contained and the log of the above-described well as filed and that the same are true and correct. So help me God.

(Signature) X Jock Garden 504 Wolcott Bldg, Hutchinson, Kansas (Address)

SUBSCRIBED AND SWORN TO before me this 5 day of May, 1939

My commission expires: Notary Public. My commission expires: 17-3443 3-38-3M

15-095-01585-0000

GARDEN-JOEL WELL #1  
SW 1/4 11-27-10W  
Kingman County, Kansas

Date Spudded - January 15, 1939  
Date Completed - February 13, 1939

CONTRACTOR - Jock Garden Contracting Company

CASING 250 ft. 12 1/2" L. W. 50# Casing  
3500 ft. 7" OD 24# S. S. Casing

FORMATION		REMARKS
Shale & Shells	0-390	
Shale & Red Bed	390-780	
Shale & Shells	780-1070	
Salt	1070-1210	
Shale & Shells	1210-1355	
Anhydrats	1355-1390	
Broken Lime	1390-1545	
Lime	1545-1605	
Broken Lime	1605-2310	
Shale & Lime	2310-2665	
Shale	2665-2740	
Shale & Lime	2740-2790	
Shale	2790-2840	
Broken Lime	2840-2925	
Sandy Shale	2925-2975	
Topoka Lime	2975-3050	
Lime	3050-3210	
Shale	3210-3250	
Lime	3250-3260	
Broken Lime	3260-3325	
Shale & Lime	3325-3435	
Shale	3435-3492	
Lime	3492-3500	Run Pipe & Cemented
Sandy Shale	3500-3509	
Lime	3509-3542	Top of Kansas City Lime First Oil from 3509-3519 -
Shale	3542-3548	
Lime	3548-3576	Increase in Oil from 3551-3553. Made Approx. 10 bbls. per day at 3365.
Lime	3576-3581	No Increase in oil at 3581. Made Approx. 100 bbls water per day after acid.

Total Depth 3581

Put in 4,000 gals. penetrating acid Feb. 11, 1939

Signed: \_\_\_\_\_

I, Jock Garden, do hereby certify that the foregoing is a true and correct log of the Joel #1, SW 1/4 11-27-10W, Kingman County, Kansas, drilled to a total depth of 3581 feet.

Subscribed and sworn to before me a Notary Public this 24th day of March, 1939.

My Commission expires \_\_\_\_\_

PLUGGING  
FILE SEC 11-T 27R 10W  
BOOK PAGE 60 LINE 14

