

Give All Information Completely
Make Required Affidavit
Mail or Deliver Report to:
Conservation Division
State Corporation Commission
212 No. Market
Wichita, Kansas 67202

WELL PLUGGING RECORD 15-155-20070-0000

Reno County, Sec. 22 Twp. 23S Rge. 4 (X) (W)

Location as "NE/CNW/SW" or footage from lines C SE SW SW

Lease Owner TGT Petroleum Corporation

Lease Name Strawn Well No. 1

Office Address 209 E. William Wichita, KS 67202

Character of Well (completed as Oil, Gas or Dry Hole) Repressuring

Date well completed September 5 19 68

Application for plugging filed May 17 19 77

Application for plugging approved May 18 19 77


Plugging commenced October 13 19 77

Plugging completed October 13 19 77

Reason for abandonment of well or producing formation Well down hole conditions did not permit water to be injected

If a producing well is abandoned, date of last production N/A 19

Was permission obtained from the Conservation Division or its agents before plugging was commenced? Yes

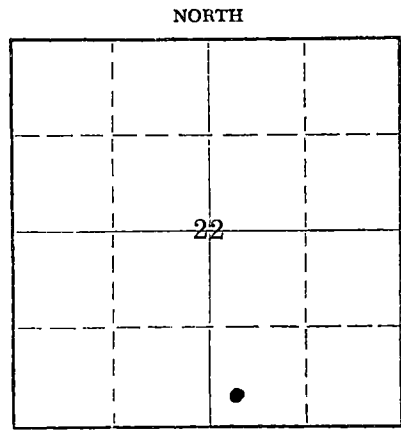

Locate well correctly on above Section Plat

Name of Conservation Agent who supervised plugging of this well Gilbert Toman

Producing formation Mississippi Depth to top 3339 Bottom 3445 Total Depth of Well 3445 Feet

Show depth and thickness of all water, oil and gas formations.

OIL, GAS OR WATER RECORDS

CASING RECORD

FORMATION	CONTENT	FROM	TO	SIZE	PUT IN	PULLED OUT
Surface		0	236	10-3/4	236	None
Salt		0	679	8-5/8	679	None
Mississippi		0	3442	4-1/2	3442	None

Describe in detail the manner in which the well was plugged, indicating where the mud fluid was placed and the method or methods used in introducing it into the hole. If cement or other plugs were used, state the character of same and depth placed, from 0 feet to 3442 feet for each plug set.

Cemented bottom of hole with 150 sx Halliburton light cement; cemented 8-5/8" casing with 150 sx Halliburton light cement; let cement set up; finish filling 4-1/2" casing to top with 125 sx.

RECEIVED
STATE CORPORATION COMMISSION
OCT 28 1977
CONSERVATION DIVISION
Wichita, Kansas

(If additional description is necessary, use BACK of this sheet)

Name of Plugging Contractor TGT Petroleum Corporation

Address

STATE OF KANSAS, COUNTY OF SEDGWICK, ss.

B. Lynn Herrington (owner or operator) of the above-described

well, being first duly sworn on oath, says: That I have knowledge of the facts, statements, and matters herein contained and the log of the above-described well as filed and that the same are true and correct. So help me God.

(Signature) *B. Lynn Herrington*
209 E. William Wichita, KS 67202
(Address)

SUBSCRIBED AND SWORN TO before me this 27th day of October 1977

Kathy Snodgrass
Notary Public.

My commission expires



15-155-20070-0000

ROTARY DRILLERS' LOG

OPERATOR: Rosen Oil Company
605 Sutton Place
Wichita, Kansas 67202

DRILLING COMMENCED: August 9, 1968

CONTRACTOR: Graves Drilling Co., Inc.
505 Union Center
Wichita, Kansas 67202

DRILLING COMPLETED: August 14, 1968

CASING RECORD: 12 Jts. 235' 10-3/4"
cemented with 275 sacks
25 Jts. 668' 8-5/8"
cemented with 100 sacks
107 Jts. 3427' 4-1/2"
cemented with 100 sacks

LOCATION: Strawn No. 1
SE SW SW
Section 22-23S-4W
Reno County, Kansas

0 - 80	Sod & sand
80 - 236	Sand & shale
236 - 680	Shale
680 - 690	Shale & lime
690 - 1385	Lime & shale
1385 - 1875	Shale
1875 - 2027	Shale & lime
2027 - 2210	Lime
2210 - 2501	Lime & shale
2501 - 2560	Sand & shale
2560 - 2807	Lime & shale
2807 - 3014	Lime
3014 - 3240	Lime & shale
3240 - 3308	Shale & lime
3308 - 3350	Lime & chert
3350 - 3445	Lime
3445	Rotary Total Depth

RECEIVED
STATE CORPORATION COMMISSION
MAY 18 1977
CONSERVATION DIVISION
Wichita, Kansas

I hereby certify the foregoing statements to be true and correct to the best of my knowledge.

GRAVES DRILLING CO., INC.

By John Graves
President

STATE OF KANSAS)
) ss:
SEDGWICK COUNTY)

Subscribed and sworn to before me, a Notary Public, this 20th of August, 1968.

Betty Brandt
Betty Brandt Notary Public

My commission expires May 9, 1971

RECEIVED AUG 29 1968