


STATE OF KANSAS
STATE CORPORATION COMMISSION

WELL PLUGGING RECORD

Give All Information Completely
Make Required Affidavit
Mail or Deliver Report to:
Conservation Division
State Corporation Commission
809 Bitting Building
Wichita, Kansas

Edwards County, Sec. 10 Twp. 24S Rge. (E) 16 (W)
Location as "NE/CNW%SW%" or footage from lines SW SW SE
Lease Owner Herndon Drilling Company
Lease Name Kirkman Well No. 1
Office Address 423 Mayo Building, Tulsa, Oklahoma
Character of Well (completed as Oil, Gas or Dry Hole) Dry hole
Date well completed 10-13 1954
Application for plugging filed 10-13 1954
Application for plugging approved 10-13 1954
Plugging commenced 10-13 1954
Plugging completed 10-13 1954
Reason for abandonment of well or producing formation _____

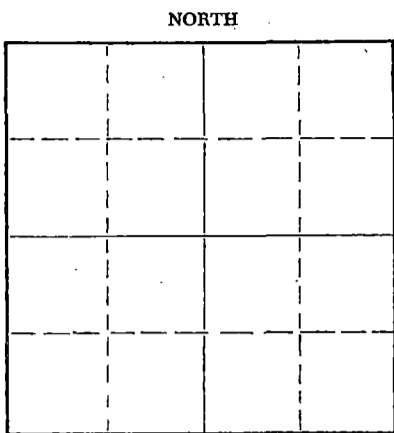

Locate well correctly on above
Section Plat

If a producing well is abandoned, date of last production _____ 19____
Was permission obtained from the Conservation Division or its agents before plugging was com-
menced? Yes

Name of Conservation Agent who supervised plugging of this well Merle Rives - Pratt, Kansas
Producing formation _____ Depth to top _____ Bottom _____ Total Depth of Well _____ Feet
Show depth and thickness of all water, oil and gas formations.

OIL, GAS OR WATER RECORDS

CASING RECORD

FORMATION	CONTENT	FROM	TO	SIZE	PUT IN	PULLED OUT

Describe in detail the manner in which the well was plugged, indicating where the mud fluid was placed and the method or methods used in introducing it into the hole. If cement or other plugs were used, state the character of same and depth placed, from 35 feet to 240 feet for each plug set.

~~Hole was filled with Rotary mud to 240 ft. 1/2 sack of hulls poured in and a plug set @ 240. 20 sacks cement was mixed and poured through drill pipe. Hole was filled to 35 ft. Top plug was set and bridged with hulls. 10 sacks cement mixed and poured in casing and filled to bottom of cellar~~

10-29-54

(If additional description is necessary, use BACK of this sheet)

Name of Plugging Contractor Herndon Drilling Company
Address Drawer 489, Tulsa, Oklahoma


STATE OF Oklahoma, COUNTY OF Tulsa, ss.
Tom Elliott (employee of owner) or ~~conservation agent~~ of the above-described well, being first duly sworn on oath, says: That I have knowledge of the facts, statements, and matters herein contained and the log of the above-described well as filed and that the same are true and correct. So help me God.

(Signature) Tom Elliott

SUBSCRIBED AND SWORN to before me this 18th day of October, 1954

(Address) _____
Arthur Green
Notary Public.

My commission expires Sept. 19, 1956

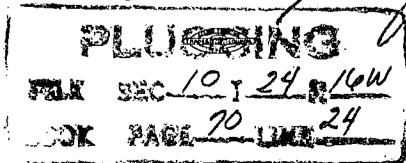

WELL LOG ON KIRKMAN #1

Spudding date: 9/29/54
 Date casing set: 9/29/54
 Date rotary completed: 10/12/54
 Date cable completed:

Location:

Sec. 10-24S-16W - Edwards Co., Kansas

<u>FROM</u>	<u>TO</u>	<u>FORMATION</u>	<u>REMARKS</u>
0	249	Sand & Shale	Ran 12 Jts. 8-5/8" Casing @ 249'
249	550	Shale & Shells	Cemented w/ 200 Sx. Pozmix
550	610	Sand	
610	1060	Shale & Shells	
1060	1095	Anhydrite	
1095	1495	Shale	
1495	3782	Shale & Lime	
3782	4085	Lime	
4085	4265	Lime & Shale	
4265	4342	Lime	
4342	4378	Lime & Chert	
4378	4399	Lime	
4399		Total Depth	

Plugging Record:

Hole filled to 240' w/ mud.
 Set plug @ 240'. Mixed
 20 Sx. Cement and poured thru
 drill pipe, filled hole to 35',
 set plug and mixed 10 sx. cement.

Subscribed and sworn to before me this 21st
 day of October, 19 54

I certify the above and foregoing to be a true and exact
 copy of the original driller's log on the KIRKMAN #1

HERNDON DRILLING COMPANY

Ray M. Mearns
 Notary Public
 My commission expires:

By: C. J. Moore
 Assistant Secretary

4-22-57

PLUGGING
 FILE SEC 10-24-16W
 BOOK PAGE 20 LINE 24