


WELL PLUGGING RECORD

Give All Information Completely
Make Required Affidavit
Mail or Deliver Report to:
Conservation Division
State Corporation Commission
212 No. Market
Wichita, Kansas

Edwards County. Sec. 21 Twp. 24S Rge. 16W (E) (W)

Location as "NE/CNW/SW" or footage from lines NW NW SW
Lease Owner D. R. Lauck Oil Company, Inc.
Lease Name Lunz "A" Well No. 1
Office Address 301 S. Broadway, Wichita, Kansas
Character of Well (completed as Oil, Gas or Dry Hole) Dry Hole
Date well completed November 11, 1967
Application for plugging filed November 11, 1967
Application for plugging approved November 11, 1967
Plugging commenced November 11, 1967
Plugging completed November 11, 1967
Reason for abandonment of well or producing formation Dry Hole

NORTH

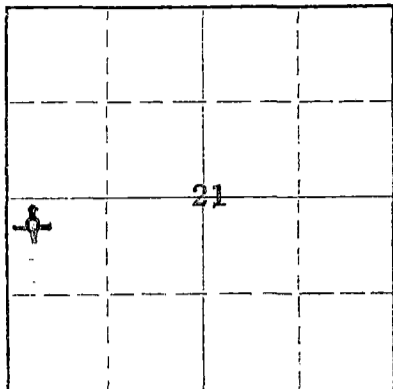

Locate well correctly on above
Section Plat

If a producing well is abandoned, date of last production _____ 19____
Was permission obtained from the Conservation Division or its agents before plugging was commenced? Yes

Name of Conservation Agent who supervised plugging of this well Herman Justis
Producing formation _____ Depth to top _____ Bottom _____ Total Depth of Well 4675 Feet
Show depth and thickness of all water, oil and gas formations.

OIL, GAS OR WATER RECORDS

CASING RECORD

FORMATION	CONTENT	FROM	TO	SIZE	PUT IN	PULLED OUT
		0'	326'	8-5/8"	326'	None

Describe in detail the manner in which the well was plugged, indicating where the mud fluid was placed and the method or methods used in introducing it into the hole. If cement or other plugs were used, state the character of same and depth placed, from _____ feet to _____ feet for each plug set.

4675'-300' Mud
300'-296' Plug
296'-256' Cement, 25 sacks
256'-40' Mud
40'-36' Plug
36'-6' Cement, 10 sacks (Bottom of cellar)

RECEIVED
STATE CORPORATION COMMISSION
NOV 27 1967
CONSERVATION DIVISION
Wichita, Kansas

(If additional description is necessary, use BACK of this sheet)

Name of Plugging Contractor Lauck Drilling Company, Incorporated
Address 301 S. Broadway, Wichita, Kansas

STATE OF KANSAS, COUNTY OF SEDGWICK, ss.
John H. Knightley (employee of owner) or (owner or operator) of the above-described well, being first duly sworn on oath, says: That I have knowledge of the facts, statements, and matters herein contained and the log of the above-described well as filed and that the same are true and correct. So help me God.

(Signature) John H. Knightley
301 S. Broadway, Wichita, Kansas
(Address)

SUBSCRIBED AND SWORN TO before me this 21st day of November, 1967.

My commission expires March 12, 1971
Stella J. Lipps Notary Public.

D. R. Lauck Oil Company, Inc.

#1 Lunz "A"

NW NW SW 21-24S-16W
Edwards County, KansasCommenced: October 30, 1967
Completed: November 11, 1967Casing Record: 326' 8-5/8" Cemented with 225 sacks Cement,
5 sacks Calcium Chloride.

Elevation: GL 2078; DF 2080; KB 2082.

Drillers Log

Tops

Drillers Log	Tops	Sample
Sand	170	
Shale	327	
Red Bed	585	Anhydrite (driller)
Sand	615	Heebner
Red Bed, some sandy	1095	Toronto
Anhydrite	1115	Douglas
Shale	1434	Brown Lime
Shale & shells	1875	Lansing
Shale & lime	2150	Mississippian
Lime & shale	2590	Kinderhook
Shale & lime	2710	Viola
Lime & shale	3785	Simpson
Shale	3822	Arbuckle
Lime	4130	Total Depth
Lime & shale	4255	
Miss.	4288	
Shale	4314	DST #1 (H) 4256-70, open 1 hour, good
Shale & lime	4365	blow. Recovered 40' mud.
Shale	4369	ISIP 507#, 30 min.
Viola	4537	FSIP 733#, 30 min.
Cher, Lime & shale	4577	IFP 18#
Sand	4583	FFP 35#
Shale	4638	
Arbuckle	4650	
Lime	4675 RTD	

D&A

RECEIVED
OIL CORPORATION COMMISSION

NOV 27 1967

CONSERVATION DIVISION
Wichita, Kansas