


STATE OF KANSAS
STATE CORPORATION COMMISSION

WELL PLUGGING RECORD

Give All Information Completely
Make Required Affidavit
Mail or Deliver Report to
Conservation Division
State Corporation Comm.
245 North Water
Wichita, KS 67202

Edward County, Sec. 26 Twp. 24S Rge. 16W E/W
Location as "NE/CNW $\frac{1}{4}$ SW $\frac{1}{4}$ " or footage from lines
SW $\frac{1}{4}$

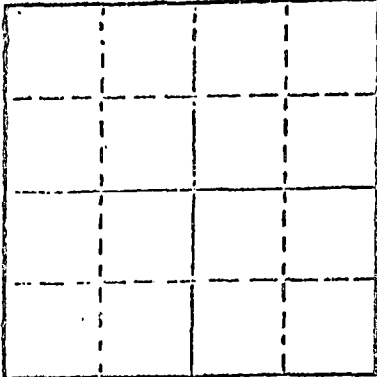

Locate well correctly on above
Section Plat

Lease Owner Herndon Oil & Gas Company
Lease Name Breitenback Well No. 2
Office Address Box 489, Tulsa, Oklahoma 74101
Character of Well (Completed as Oil, Gas or Dry Hole)
Dry Hole

Date Well completed April 17, 19 81
Application for plugging filed April 17, 19 81
Application for plugging approved April 17, 19 81
Plugging commenced April 17, 19 81
Plugging completed April 17, 19 81
Reason for abandonment of well or producing formation
Dry

If a producing well is abandoned, date of last production
19

Was permission obtained from the Conservation Division or
its agents before plugging was commenced? Yes

Name of Conservation Agent who supervised plugging of this well Wm. T. Owen
Producing formation _____ Depth to top _____ Bottom _____ Total Depth of Well _____
Show depth and thickness of all water, oil and gas formations.

OIL, GAS OR WATER RECORDS

CASING RECORD

FORMATION	CONTENT	FROM	TO	SIZE	PUT IN	PULLED OUT

Describe in detail the manner in which the well was plugged, indicating where the mud fluid was placed and the method or methods used in introducing it into the hold. If cement or other plugs were used, state the character of same and depth placed, from _____ feet to _____ feet for each plug set.

- Set first plug @ 620' with 60 sacks
- Set second plug @ 320' with 40 sacks
- Set third plug @ 40' with 10 sacks
- 10 sacks in the rat hole

(If additional description is necessary, use BACK of this sheet)

Name of Plugging Contractor _____


STATE OF Kansas COUNTY OF Sedgwick, ss.
R. D. Messinger (employee of owner) or (owner or operator
of the above-described well, being first duly sworn on oath, says: That I have knowledge of the facts, statements, and matters herein contained and the log of the above-described well as filed and that the same are true and correct. So help me God.

(Signature) R. D. Messinger
422 Union Center, Wichita, Kansas 67202
(Address)

SUBSCRIBED AND SWORN TO before me this 14th day of April, 19 81

My commission expires 12-24-84

Shirley A. Gallegos
Shirley A. Gallegos Notary Public.

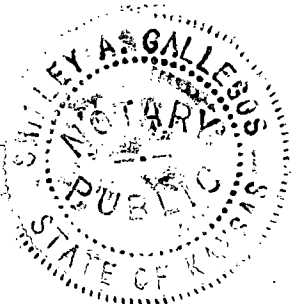

RECEIVED
STATE CORPORATION COMMISSION
MAY 14 1981
5-14 1981
CONSERVATION DIVISION
Wichita, Kansas

CONTRACTOR'S WELL LOG

OPERATOR:	Herndon Oil & Gas Company
CONTRACTOR:	Union Drilling Co., Inc.
LEASE NAME:	#2 Breitenback
LOCATION:	SW ¼ Section 26-24S-16W Edward County, Kansas
COMMENCED:	April 11, 1981
COMPLETED:	April 17, 1981

0	1086	Redbed & shale	Set 8-5/8" @ 320' with 265 sacks common cement 2% gel, 3% CC
1086	1620	Shale	
1620	2907	Lime & shale	
2907	3329	Shale & lime	
3329	3521	Lime & shale	
3521	3969	Shale & lime	
3969	4385	Lime & shale	
4385		TD	

We certify that the above foregoing is a true and correct copy of the log on the #2 Breitenback, SW¼ Section 26-24S-16W, Edward County, Kansas.

Union Drilling Co., Inc.

R. D. Messinger

 R. D. Messinger

STATE OF KANSAS)
) SS
 COUNTY OF SEDGWICK)

Subscribed and sworn to before me, a Notary Public, in and for the aforesaid County and State as of this 14th day of April, 1981.

My appointment expires:

 12-24-84

Shirley A. Gallegos

 Shirley A. Gallegos-Notary Public



RECEIVED
 STATE CORPORATION COMMISSION
 MAY 14 1981
 CONSERVATION DIVISION
 Wichita, Kansas