


STATE OF KANSAS
STATE CORPORATION COMMISSION

Give All Information Completely
Make Required Affidavit
Mail or Deliver Report to:
Conservation Division
State Corporation Commission
800 Bitting Building
Wichita, Kansas

WELL PLUGGING RECORD

NORTH

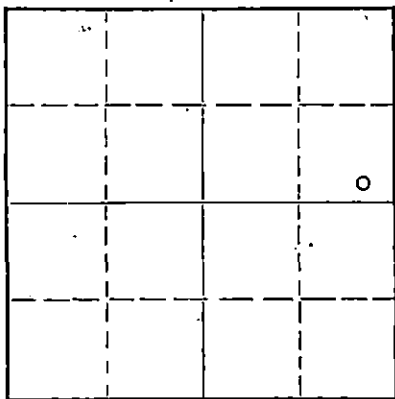

Locate well correctly on above
Section Plat

Stafford

County. Sec. 12 Twp. 24 Rge. (E) 12 (W)

Location as "NE/CNW/SW" or footage from lines SE SE NE

Lease Owner The Derby Oil Company

Lease Name McKibben

Well No. 1

Office Address Box 1030, Wichita, Kansas

Character of Well (completed as Oil, Gas or Dry Hole) Oil Well

Date well completed November 28, 1954

Application for plugging filed April 30, 1954

Application for plugging approved May 3, 1954

Plugging commenced May 17, 1954

Plugging completed June 1, 1954

Reason for abandonment of well or producing formation Production depleted

If a producing well is abandoned, date of last production April 30, 1954

Was permission obtained from the Conservation Division or its agents before plugging was commenced? Yes

Name of Conservation Agent who supervised plugging of this well Merle Rives

Producing formation Viola Depth to top 3824 Bottom Total Depth of Well Feet

Show depth and thickness of all water, oil and gas formations.

OIL, GAS OR WATER RECORDS

CASING RECORD

FORMATION	CONTENT	FROM	TO	SIZE	PUT IN	PULLED OUT
				8 5/8"	325'	None
				5 1/2"	4007'	2499'

Describe in detail the manner in which the well was plugged, indicating where the mud fluid was placed and the method or methods used in introducing it into the hole. If cement or other plugs were used, state the character of same and depth placed, from feet to feet for each plug set.

160' rock from 3970 to 3810'

5 sacks cement from 3810 to 3770'

Pumped 25 sacks jel-mud into hole w/Halliburton, approx. 300# pressure.

Tied measuring line to HOWCO plug & pumped plug down to 302' using 100 sacks cement w/HOWCO, approx. 500# pressure.

RECEIVED
STATE CORPORATION COMMISSION
JUN 15 1954

6-15-54
CONSERVATION DIVISION
Wichita, Kansas

(If additional description is necessary, use BACK of this sheet)

Name of Plugging Contractor Walker Drilling, Inc.

Address Hutchinson, Kansas

STATE OF KANSAS, COUNTY OF SEDGWICK, ss.

Bill K. Henrichs

(employee of owner) or (owner or operator) of the above-described

well, being first duly sworn on oath, says: That I have knowledge of the facts, statements, and matters herein contained and the log of the above-described well as filed and that the same are true and correct. So help me God.

(Signature)


Box 1030, Wichita, Kansas

(Address)

SUBSCRIBED AND SWORN TO before me this 10th day of June, 1954

Mary L. Barnes
Notary Public.

My commission expires November 7, 1957

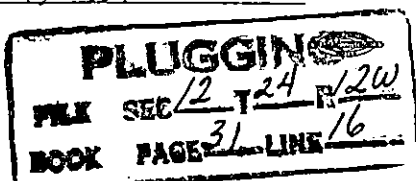

THE DERBY OIL COMPANY

Record of Well No. 1
 Location: SE NE
 Contractor: E. K. Carey
 Drilling Commenced: 10-11-44
 Elevation: 1347

Farm: McKibben
 Sec. 12 Twp. 24 Rge. 12W
 Count.: Stafford
 State: Kansas
 Drilling Comp.: 11-23-44

CASING RECORD

size	feet	kind	weight	
8 5/8"	325'	OD	24#	175 sack cement by Halliburton
5 1/2"	4007'		14#	175 " "

Formation	Bottom	Formation	Bottom
Surface Dirt & Clay	15		
Sand	25		
Shale or Clay	35		
Sand & Shale streaks	105		
Red Rock	120		
Red Rock & Shells	175		
Red Rock & Sand	230		
Red Rock	325		
Shale	335		
Red Bed	608		
Anhydrite	630		
Red Bed	735		
Red Bed, Shale & Shells	1145		
Shale & Salt	1440		
Shale & Shells	1460		
Shale & Lime	1600		
Lime	1965		
Shale	2015		
Shale & Lime	2690		
Shale	2755		
Shale & Lime	2850		
Lime	3296		
Shale & Lime	3369		
Shale	3412		
Lime & Shale	3452		
Lime	3582		
Lime cherty	3608		
Lime	3741		
Shale & Lime	3787		
Shale	3815		
Lime	3844		
Shale & Lime	3861		
Cherty Cong.	3873		
Lime	3917		
Lime Cherty	3949		
Lime	3965		
Shale	4008		

GEOLOGICAL SURVEY

Tops:

Lans. 3414'
 Viola 3824'
 Simp. Sh. 3964'
 Arb. 4001'

Total Depth 4008'

Fair por. & very light stain
 3324-42. Good por. no sat.
 in Arb.. DP to 3970 Perf.
 12/3818-26, 12/3822-26, 1000'
 oil no wtr. 20 hrs. 500A swab
 14 BO no wtr. 3 hrs. after
 swabbing down. 2000A Swab 18 BX
 no wtr. Hr. 3 hrs. after swab-
 ing down.

Comp. Pump Pot. 290 BO 73 SW

RECEIVED
 STATE CONSERVATION COMMISSION

MAY 1 - 1951

CONSERVATION DIVISION
 Wichita, Kansas

