


15-095-20367-0000

STATE OF KANSAS
STATE CORPORATION COMMISSION

Form CP-4

WELL PLUGGING RECORD

Give All Information Completely
Make Required Affidavit
Mail or Deliver Report to:
Conservation Division
State Corporation Commission
P. O. Box 17027
Wichita, Kansas 67217
NORTH

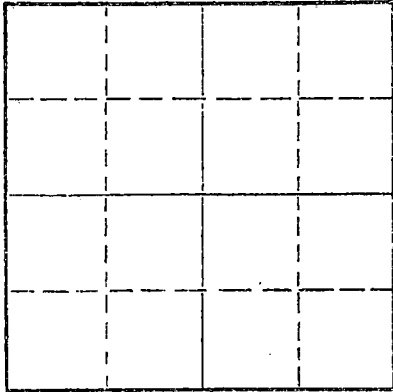

Locate well correctly on above
Section Plat

Kingman County. Sec. 8 Twp. 28S Rge. 5W (E) (W)
Location as "NE/CNW/SW" or footage from lines W/2 SE SW
Lease Owner John O. Farmer
Lease Name Whitelaw Well No. 1
Office Address 370 W. Wichita, Russell, Kansas
Character of Well (completed as Oil, Gas or Dry Hole) Dry Hole
Date well completed September 9, 19 74
Application for plugging filed September 9, 19 74
Application for plugging approved September 9, 19 74
Plugging commenced September 9, 19 74
Plugging completed September 9, 19 74
Reason for abandonment of well or producing formation Dry Hole

If a producing well is abandoned, date of last production 19
Was permission obtained from the Conservation Division or its agents before plugging was commenced? yes.

Name of Conservation Agent who supervised plugging of this well G. R. Biberstein
Producing formation Depth to top Bottom Total Depth of Well 3900' Feet
Show depth and thickness of all water, oil and gas formations.

OIL, GAS OR WATER RECORDS

CASING RECORD

FORMATION	CONTENT	FROM	TO	SIZE	PUT IN	PULLED OUT
				8-5/8	229'	None

Describe in detail the manner in which the well was plugged, indicating where the mud fluid was placed and the method or methods used in introducing it into the hole. If cement or other plugs were used, state the character of same and depth placed, from feet to feet for each plug set.

Bottom Plug 200'. 35 sacks cement.

Top Plug 40' bridged plug 15 sacks comp. 11:30 A.M. 9/9/74.

RECEIVED
STATE CORPORATION COMMISSION
SEP 16 1974
CONSERVATION DIVISION
Wichita, Kansas

(If additional description is necessary, use BACK of this sheet)
Name of Plugging Contractor Pickrell Drilling Company
Address 705 Fourth National Bank Bldg., Wichita, Kansas 67202.

STATE OF Kansas, COUNTY OF Sedgwick, ss.
C. W. Sebitts (employee of owner) or (owner or operator) of the above-described well, being first duly sworn on oath, says: That I have knowledge of the facts, statements and matters herein contained and the log of the above-described well as filed and that the same are true and correct. So help me God.

(Signature) C. W. Sebitts
705 Fourth National Bank Bldg., Wichita, Ks. 67202
(Address)

SUBSCRIBED AND SWORN TO before me this 9th day of September, 19 74

My commission expires August 19, 1975

Helen L. Martin
Notary Public.

ROTARY DRILLING LOG

15-095-20367-0000

COMPANY: John O. Farmer
370 W. Wichita
Russell, Kansas
LOCATION: Whitelaw #1
W/2 SE SW, Sec. 8-28S-5W
Kingman County, Kansas

Rotary Drilling Commenced August 31, 1974
Rotary Drilling Completed Sept. 9, 1974

CONTRACTOR: **PICKRELL DRILLING COMPANY**
Wichita, Kansas

CASING RECORD: (6 joints) 8-5/8 surface casing set at 229' and cemented with 180 sacks cement. Job completed 9-1-74 @ 1:00 A.M. P & A, plugged 9-9-74.

LOG

(Figures indicate bottom of formation = measurements from top of rotary bushing.)

10	Sand	=	<u>C.F.S.</u>
232	Red Bed		
349	Shale & Lime		3780'
900	Shale & Lime		3795'
1190	Lime & Shale		3900'
1385	Lime & Shale		
1590	Lime		
1680	Lime & Shale		
1793	Shale & Lime		
1950	Shale		
2240	Shale & Lime	Streaks	
2447	Shale & Lime		
2665	Shale & Lime		
2895	Shale & Lime		
3090	Shale & Lime		
3155	Lime		
3265	Shale & Lime		
3350	Lime		
3440	Lime		
3535	Shale & Lime		
3610	Lime & Shale		
3685	Lime & Shale		
3780	Shale & Lime		
3795	Shale & Lime		
3830	Chalky Lime		
3900	Chalky Lime		

RECEIVED
STATE CORPORATION COMMISSION
SEP 16 1974
CONSERVATION DIVISION
Wichita, Kansas

The undersigned, C. W. Sebitts, Attorney-in-Fact for PICKRELL DRILLING COMPANY, hereby certifies in behalf of said Company, that the above is a true and correct log of the formation encountered in drilling the above well as reflected by the Daily Drilling Reports.

PICKRELL DRILLING COMPANY
By [Signature]
C. W. Sebitts Attorney-in-Fact

STATE OF KANSAS }
COUNTY OF SEDGWICK } ss.:

On this 9th day of September, 19 74, before me the undersigned, a Notary Public, in and for the County and State aforesaid, personally appeared C. W. Sebitts, to me known to be the identical person who subscribed the name of PICKRELL DRILLING COMPANY to the foregoing instrument as its Attorney-in-Fact and acknowledged to me that he executed the same as his free and voluntary act and deed, and as the free and voluntary act and deed of such company, for the uses and purposes therein set forth.

Given under my hand and seal of office the day and year last above written.

My commission expires: August 19, 1975

[Signature]
Notary Public
Helen L. Martin