


Give All Information Completely
Make Required Affidavit
Mail or Deliver Report to:
Conservation Division
State Corporation Commission
800 Bitting Building
Wichita, Kansas

WELL PLUGGING RECORD

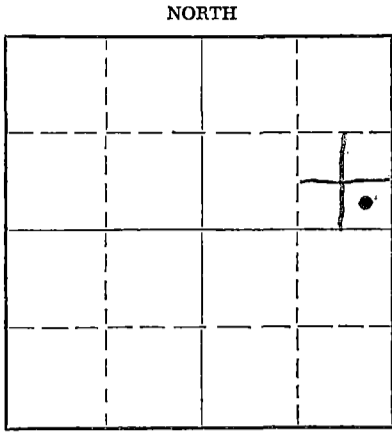

Locate well correctly on above Section Plat

Kingman County. Sec. 9 Twp. 28S Rge. 5W (E) (W)
Location as "NE/CNW/SW" or footage from lines CSE/SE/NE
Lease Owner Shallow Water Refining Co.
Lease Name Ash Well No. 2
Office Address Ward Parkway Bank Bldg. Kansas City, Mo.
Character of Well (completed as Oil, Gas or Dry Hole) Dry Hole
Date well completed 10/18/55 19
Application for plugging filed 10/18/55 19
Application for plugging approved 10/18/55 19
Plugging commenced 10/18/55, 2:00 PM 19
Plugging completed 10/18/55, 4:30 PM 19
Reason for abandonment of well or producing formation Dry Hole

If a producing well is abandoned, date of last production _____ 19
Was permission obtained from the Conservation Division or its agents before plugging was commenced? Yes, from M. A. Rives, Pratt Kansas

Name of Conservation Agent who supervised plugging of this well M. A. Rives, Pratt, Kansas
Producing formation None Depth to top _____ Bottom _____ Total Depth of Well 3881 Feet
Show depth and thickness of all water, oil and gas formations.

OIL, GAS OR WATER RECORDS

CASING RECORD

FORMATION	CONTENT	FROM	TO	SIZE	PUT IN	PULLED OUT
Surface		0	150	8 5/8	150	

Describe in detail the manner in which the well was plugged, indicating where the mud fluid was placed and the method or methods used in introducing it into the hole. If cement or other plugs were used, state the character of same and depth placed, from _____ feet to _____ feet for each plug set.

Set wooden plug at 150', with 1/4 sack of hulls on top. Ran 20 sacks of cement, through drill pipe, on top of plug. Set second plug with 1/2 sack of hulls, at 35'. 5 sacks of cement filled hole.

(If additional description is necessary, use BACK of this sheet)

Name of Plugging Contractor Beardmore Drilling Co.
Address Beacon Bldg. Wichita, Kan.

STATE OF Kansas, COUNTY OF Sedgwick, ss.
Ben K. Kelley (employee of ~~owner~~ operator) of the above-described well, being first duly sworn on oath, says: That I have knowledge of the facts, statements, and matters herein contained and the log of the above-described well as filed and that the same are true and correct. So help me God.

(Signature) Ben K. Kelley
78 Random Road, Hutchinson, Kansas
(Address)

SUBSCRIBED AND SWORN TO before me this 25th day of October, 19 55

My commission expires February 4, 1959.

[Signature]
Notary Public.

PLUGGING
FILE SEC 9 T 28 R 50
BOOK PAGE 10 LINE 6

24-7368-5

RECEIVED
NOV - 1 1955
11-01-55
CONSERVATION DIVISION
Wichita, Kansas

15095-00089-0000

SHALLOW WATER REFINING COMPANY

#2 Ash
SE SE NE
Sec. 9-28S-5W, Kingman County

Drilled By: Beardmore Drilling Company
Drilling Commenced: 10-10-55
Drilling Completed: 10-17-55

Casing Record:

Set 150' of 8 5/8" with 125 sacks. Cement circulated. 10-10-55.

Elevations: KB 1416
DF 1413
Gr 1411

<u>FORMATIONS</u>	<u>DEPTH</u>
Cellar	5
Soil and Clay	40
Sand	50
R. R. Shale and Shells	150
Shale and Shells	410
Shale and Lime	1145
Lime	1345
Shale and Lime	2690
Shale and Lime	3040
Lime, broken	3145
Shale and Lime	3250
Lime	3380
Shale and Lime	3470
Shale and Lime	3730
Lime and Chert	3818
Lime	3847
Lime and Chert	3875
Lime	3881
Total Depth	3882

TOPS

Lansing 2792 (-1579)
Mississippi Chert 3782 (-2379)

DRILL STEM TEST #1 3805-3818' - Open 1 hr. Shut in 20 min. Good blow. 90' gas cut muddy water and 30' muddy water. B.H.P. - 695 I.F.-55 F.F. - 55.

DRILL STEM TEST #2 3826-3847 - Open 1 hr. Shut in 20 min. 30' oil cut mud, 120' slightly oil cut mud, 420' muddy salt water. B.H.P. - 1180 I.F. - 125 F.F. - 250.

STATE OF KANSAS)
) ss
COUNTY OF SEDGWICK)

I, the undersigned, being duly sworn on oath state that the above and within statement is a true and correct record and log of the well drilled on the location above-described, to the best of my knowledge and belief,

Robert J. Gutru

Subscribed and sworn to before me this 27th day of October, 1955.

Notary Public

My Commission Expires:
January 28, 1956

RECEIVED
STATE OF KANSAS

PLUGGING
FILE SEC 9-28-5W
PAGE 10 LINE 6

1955
DIVISION