


15095-01474-000

STATE OF KANSAS  
STATE CORPORATION COMMISSION  
Give All Information Completely  
Make Required Affidavit  
Mail or Deliver Report to:  
Conservation Division  
State Corporation Commission  
800 Biting Building  
Wichita, Kansas

WELL PLUGGING RECORD

Kingman County, Sec. 9 Twp. 28 Rge. 5W (E) (W)

Location as "NE/CNW%SW%" or footage from lines SW NW NE  
Lease Owner Sapphire Petroleum Corp.  
Lease Name Padget Well No. 1  
Office Address 710 San Angelo Nat. Bk., San Angelo, Texas  
Character of Well (completed as Oil, Gas or Dry Hole) Dry  
Date well completed 3-28-52 19  
Application for plugging filed 9-29-53 19  
Application for plugging approved 9-29-53 19  
Plugging commenced 9-29-53 19  
Plugging completed 10-16-53 19  
Reason for abandonment of well or producing formation \_\_\_\_\_

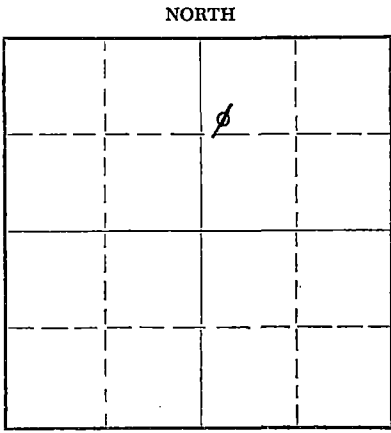

Locate well correctly on above Section Plat

If a producing well is abandoned, date of last production \_\_\_\_\_ 19  
Was permission obtained from the Conservation Division or its agents before plugging was commenced? Yes

Name of Conservation Agent who supervised plugging of this well Warren H. Horner  
Producing formation \_\_\_\_\_ Depth to top \_\_\_\_\_ Bottom \_\_\_\_\_ Total Depth of Well 4220 Feet  
Show depth and thickness of all water, oil and gas formations.

OIL, GAS OR WATER RECORDS

CASING RECORD

FORMATION	CONTENT	FROM	TO	SIZE	PUT IN	PULLED OUT
				8-5/8"	162'	None
				5 1/2"	4192'	2700'

Describe in detail the manner in which the well was plugged, indicating where the mud fluid was placed and the method or methods used in introducing it into the hole. If cement or other plugs were used, state the character of same and depth placed, from \_\_\_\_\_ feet to \_\_\_\_\_ feet for each plug set.

Surface Pipe 8-5/8 @ 162' C.W.C.  
Filled hole back with sand to 4180' and dumped 6 sacks of cement with dump bailer. Shut off and pulled 5 1/2" casing @ 2700'. Filled hole with heavy mud to 155'. Set 10' rock bridge and mixed and run 15 sacks of cement. Mudded hole to 30'. Set rock bridge and dumped 5 sacks of cement to surface to complete plugging.

(If additional description is necessary, use BACK of this sheet)

Name of Plugging Contractor Forbes Casing Pulling Co.  
Address Box 221, Great Bend, Kansas

STATE OF Texas COUNTY OF Tom Green, ss.  
J.R. Rich, Operations Mgr. (employee of owner) or (~~owner or operator~~) of the above-described well, being first duly sworn on oath, says: That I have knowledge of the facts, statements, and matters herein contained and the log of the above-described well as filed and that the same are true and correct. So help me God

(Signature) J.R. Rich  
(Address) \_\_\_\_\_

SUBSCRIBED AND SWORN TO before me this 9 day of Dec, 1953

My commission expires June-1-1954  
Vera Calles Notary Public.

24-7366-S 3-53-20M  
PLUGGING  
FILE SEC 9 T 28 R 5W  
BOOK PAGE 132 LINE 19

12-11-53

