


WELL PLUGGING RECORD

Give All Information Completely  
Make Required Affidavit  
Mail or Deliver Report to:  
Conservation Division  
State Corporation Commission  
800 Bitting Building  
Wichita, Kansas

NORTH

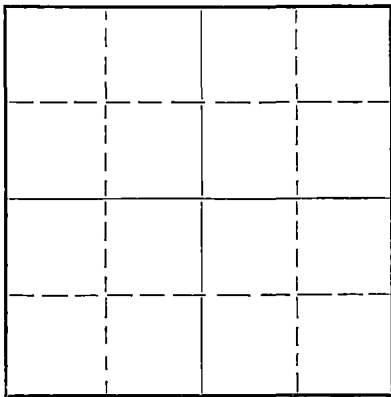

Locate well correctly on above  
Section Plat

Kingman County. Sec. 9 Twp. 28 Rge. (E) 5 (W)  
Location as "NE/CNW $\frac{1}{4}$ SW $\frac{1}{4}$ " or footage from lines NE NE SW  
Lease Owner Pabco Drilling, Inc et al  
Lease Name Schomacker Well No. 3  
Office Address Wichita Kansas  
Character of Well (completed as Oil, Gas or Dry Hole) dry hole  
Date well completed 10-21-51 19  
Application for plugging filed oral 11-13-51 19  
Application for plugging approved " 11-13-51 19  
Plugging commenced 11-14-51 19  
Plugging completed 11-18-51 19  
Reason for abandonment of well or producing formation

If a producing well is abandoned, date of last production 19  
Was permission obtained from the Conservation Division or its agents before plugging was commenced? yes

Name of Conservation Agent who supervised plugging of this well Roul Durkee  
Producing formation Depth to top Bottom Total Depth of Well 3865 Feet  
Show depth and thickness of all water, oil and gas formations.

OIL, GAS OR WATER RECORDS

CASING RECORD

Formation	Content	From	To	Size	Put In	Pulled Out
				8-5/8"	1571	none
				5-1/2"	38221	32251

Describe in detail the manner in which the well was plugged, indicating where the mud fluid was placed and the method or methods used in introducing it into the hole. If cement or other plugs were used, state the character of same and depth placed, from feet to feet for each plug set.

3865 to 3790 filled with sand, 3790 to 3755 cemented with 6 sx cement, 3755 to 160 mudded, 160 to 145 rock bridge, 145 to 105 cemented with 15 sx cement, 105 to 30 filled with mud, 30 to cellar cemented with 9 sx cement.

(If additional description is necessary, use BACK of this sheet)

Name of Plugging Contractor R. & S. Pipe Pulling Co  
Address Box 192 Ellinwood Kansas

STATE OF Kansas, COUNTY OF Sedgwick, SS.  
D. J. Briggs (employee of owner) or owner/operator of the above-described well,

being first duly sworn on oath, says: That I have knowledge of the facts, statements, and matters herein contained and the log of the above-described well as filed and that the same are true and correct. So help me God. PABCO DRILLING, INC.

RECEIVED  
STATE CORPORATION COMMISSION

(Signature) By D. J. Briggs  
Wichita Kansas (Address)

SUBSCRIBED AND SWORN to before me this 29th day of November 19 51.

Wichita, Kansas

Ruth M. Gardner  
Notary Public.

My commission expires March 2, 1953

23-8390-s 6-51-20M

PLUGGING  
WELL SEC 9 T 28 R 5 W  
BOX PAGE 126 LINE 37

15-095-01475-000

D R I L L E R S   L O G

COMPANY: Pabco Drilling, Inc. et al  
CONTRACTOR: Pabco Drilling, Inc.

LOCATION: NE NE SW  
9-28S-5W  
Kingman Co.

FARM NAME: No. 3 Schomacker

COMMENCED: 8-17-51  
COMPLETED: 8-29-51

CASING USED:

8-5/8"      157'      cem w/100 sx  
5-1/2"      3800'      cem w/ 30 sx

Clay & Sand	60	
Red Bed & Shale	135	
Shale & Shale & Red Bed	157	
Shale & Shells	490	ST & SLM OK @ 500
Shale & Lime	835	
Lime	1315	ST & SLM OK @ 1000
Lime & Shale	1485	ST & SLM OK @ 1500
Lime	3075	ST & SLM OK @ 2000 & 2850
Lime & Shale	3515	ST & SLM OK @ 3350
Lime	3858	CIR 3832, 3844
Total Depth	3865	CIR 3865 & DST

STATE OF KANSAS )  
                          ) SS:  
SEDGWICK COUNTY)

I, D. J. Briggs, do hereby certify that the above is a true and correct copy of the log on the above captioned well, as shown on the daily drilling reports.

PABCO DRILLING, INC.

D. J. Briggs  
D. J. Briggs

Subscribed and sworn to before me this 30th day of August, 1951.

Russ M. Gardner  
Notary Public

My commission expires March 2, 1953.

RECEIVED  
STATE CORPORATION COMMISSION  
DEC - 1 1951  
CONSERVATION DIVISION  
Wichita, Kansas

PLUGGING  
FILE SEC 9 T 18 R 50  
BOOK PAGE 126 LINE 57