


WELL PLUGGING RECORD

Give All Information Completely
Make Required Affidavit
Mail or Deliver Report to:
Conservation Division
State Corporation Commission
800 Biting Building
Wichita, Kansas

Kingman County, Sec. 10 Twp. 28S Rge. (E) 5 (W)

Location as "NE/CNW/SW" or footage from lines NE NE SE
Lease Owner Magnolia Petroleum Co.
Lease Name Ernest PALMER Well No. 1
Office Address Box 770 - Great Bend, Kansas
Character of Well (completed as Oil, Gas or Dry Hole) Dry
Date well completed 1-22-53 19
Application for plugging filed 1-23-53 19
Application for plugging approved 1-24-53 19
Plugging commenced 9-12-53 19
Plugging completed 9-18-53 19
Reason for abandonment of well or producing formation Well drilled dry

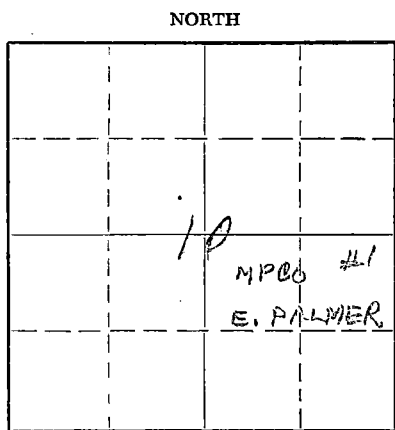

Locate well correctly on above Section Plat

If a producing well is abandoned, date of last production - 19
Was permission obtained from the Conservation Division or its agents before plugging was commenced? Yes

Name of Conservation Agent who supervised plugging of this well Ruel Durkee
Producing formation None Depth to top Bottom Total Depth of Well 3890 Feet
Show depth and thickness of all water, oil and gas formations.

OIL, GAS OR WATER RECORDS

CASING RECORD

FORMATION	CONTENT	FROM	TO	SIZE	PUT IN	PULLED OUT
				8-5/8"	200	None
				5-1/2"	3887	510

Describe in detail the manner in which the well was plugged, indicating where the mud fluid was placed and the method or methods used in introducing it into the hole. If cement or other plugs were used, state the character of same and depth placed, from feet to feet for each plug set.

Filled hole from plug back total depth 3190 to 3040' w/crushed rock & 6 sx cmnt.

Shot csg off @ 551' - pulled csg out of hole. Filled hole w/heavy mud to btm of surf pipe. Set permanent rock bridge @ 200'. Dumped 15 sx cmnt, filled hole to 30' of top w/heavy mud, dumped 10 sx cmnt for cap on well.

All plugging & mudding as per Ruel Durkee, State Plugger.

(If additional description is necessary, use BACK of this sheet)
Name of Plugging Contractor Forbes Casing Pulling Co.,
Address Great Bend, Kansas


STATE OF KANSAS, COUNTY OF BARTON, ss.
C. A. HILL (employee of owner) of the above-described well, being first duly sworn on oath, says: That I have knowledge of the facts, statements, and matters herein contained and the log of the above-described well as filed and that the same are true and correct. So help me God.

(Signature) [Signature]
Box 770 - Great Bend, Kansas (Address)

SUBSCRIBED AND SWORN TO before me this 28th day of September, 19 53

My commission expires January 14, 1957

Harriett S. Kaiser Notary Public.
RECEIVED
STATE CORPORATION COMMISSION
SEP 29 1953
09-29-53
WICHITA, KANSAS

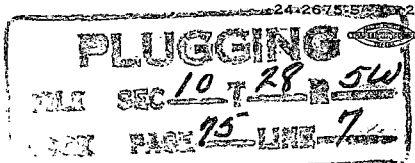

WELL LOG

15095-01479-0000

Ernest PALMER #1
NE NE SE Section

KINGMAN COUNTY
SECTION 10-28S-5W

CHASE DISTRICT

STATE OF KANSAS

DRILLING COMMENCED
DRILLING COMPLETED

12/6/52
1/22/53

Barnett Drilling Company
Wichita, Kansas

Elevation 1413 KB

Kelly Bushing to Gr. Elev. 4 1/2'

FORMATION

Clay	0	30
Sand	30	38
Red Bed	38	100
Red Bed & Shale	100	600
Shale & Lime	600	830
Lime	830	1365
Lime & Shale	1365	3000
Lime	3000	3210
Lime & Shale	3210	3270
Lime	3270	3405
Lime & Shale	3405	3800
Lime	3800	3814
Cherty Lime	3814	3820
Lime	3820	3890 TD

TOTAL DEPTH DRILLED 3890'
 OIL STRING SET 5 1/2" @ 3887'
 PLUG BACK DETPH 3071' (Temp)

AVERAGE HOLE DIAMETER - 7 7/8"

COMPLETION HISTORY:

This well was drilled dry and temp abdn 1/22/53.

PLUGGING
 MAR 10 1953
 PAGE 15 LINE 7

RECORDED
 INDEXED
 MAR 10 1953
 DIVISION OF OIL AND GAS