


15-095-00242-000

STATE OF KANSAS
STATE CORPORATION COMMISSION
Give All Information Completely
Make Required Affidavit
Mail or Deliver Report to:
Conservation Division
State Corporation Commission
800 Biting Building
Wichita, Kansas

WELL PLUGGING RECORD

Kingman County. Sec. 7 Twp. 28S Rge. 8W (E) (W)

Location as "NE/CNW/SW" or footage from lines NW NE SE
Lease Owner National Cooperative Refinery Association
Lease Name Milford Well No. 1
Office Address 305 Rule Building, Wichita, Kansas
Character of Well (completed as Oil, Gas or Dry Hole) Dry Hole
Date well completed March 18, 1957
Application for plugging filed March 18, 1957
Application for plugging approved March 18, 1957
Plugging commenced March 18, 1957
Plugging completed March 18, 1957
Reason for abandonment of well or producing formation Dry Hole

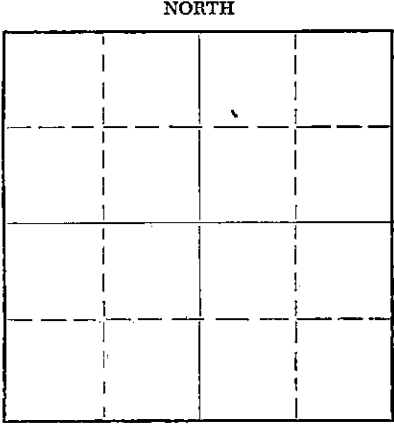

Locate well correctly on above Section Plat

If a producing well is abandoned, date of last production 19
Was permission obtained from the Conservation Division or its agents before plugging was commenced? Yes

Name of Conservation Agent who supervised plugging of this well M. A. Rives
Producing formation Depth to top Bottom Total Depth of Well 447 Feet
Show depth and thickness of all water, oil and gas formations.

OIL, GAS OR WATER RECORDS

CASING RECORD

FORMATION	CONTENT	FROM	TO	SIZE	PUT IN	PULLED OUT
				8 5/8"	297'	None-Cemented

Describe in detail the manner in which the well was plugged, indicating where the mud fluid was placed and the method or methods used in introducing it into the hole. If cement or other plugs were used, state the character of same and depth placed, from feet to feet for each plug set.

Mudded hole to 275', set Globe bridge plug plus 1/4 sack hulls plus 20 sacks of cement. Mudded hole to 40', set Globe bridge plug plus 1/4 sack hulls plus 10 sacks of cement. Filled on up to base of cellar.

(If additional description is necessary, use BACK of this sheet)

Name of Plugging Contractor Group Exploration Company
Address Sterling, Kansas.

STATE OF Kansas, COUNTY OF Sedgwick, ss.
C. R. Sears (employee of owner) or (owner) of the above-described

well, being first duly sworn on oath, says: That I have knowledge of the facts, statements, and matters herein contained and the log of the above-described well as filed and that the same are true and correct. So help me God.

(Signature) C. R. Sears (C. R. Sears)

305 Rule Building, Wichita, Kansas (Address)

SUBSCRIBED AND SWORN to before me this 25th day of March, 1957

My commission expires November 26, 1960.

Notary Public. RECEIVED

PLUGGING
FILE SEC 7 T 28 R 8W
BOOK PAGE 148 LINE 44

RECEIVED
STATE CORPORATION COMMISSION

MA
03-26-57

15-095-00242-0000

GROUP EXPLORATION COMPANY
Sterling, Kansas

WELL LOG-----MILFORD #1

Location: NW NE SE, Section 7-28S-8W,
Kingman County, Kansas

OWNER: National Cooperative Refinery Association
ROTARY DRILLING CONTRACTOR: Group Exploration Company

COMMENCED: 2-25-57
COMPLETED: 3-18-57

TOTAL DEPTH: 4447'

LOG

0-40	Sand
40-200	Red Bed
200-290	Red Bed & Shale
290-298	Shale
298-620	Shale & Shells
620-1140	Shale
1140-1170	Anhydrite
1170-1270	Limestone
1270-1430	Limestone & Shale
1430-1615	Limestone
1615-2835	Shale & Limestone
2835-2930	Limestone
2930-3295	Limestone & Shale
3295-3345	Limestone, Shale & Sand
3345-3695	Limestone
3695-3755	limestone & Chert
3755-3987	Limestone & Shale
3987-4002	Limestone
4002-4041	Mississippi Chert
4041-4060	Limestone
4060-4075	Limestone & Chert
4075-4130	Limestone
4130-4285	Shale & Limestone
4285-4320	Limestone
4320-4328	Simpson
4328-4365	Simpson, Limestone & Shale
4365-4425	Sand & Shale
4425-4447	Arbuckle Limestone

CASING RECORD

Ran 290' of 8-5/8" casing set with
200 sacks cement plus 4 sacks calcium
chloride.

PRODUCTION

Plugged & Abandoned

PLUGGING	
FILE	SEC. 7 T 28 R 8W
BOOK	PAGE 148 LINE 44

RECEIVED
STATE CORPORATION COMMISSION
APR 9 - 1957
CONSERVATION DIVISION