

STATE CORPORATION COMMISSION OF KANSAS
OIL & GAS CONSERVATION DIVISION
WELL COMPLETION OR RECOMPLETION FORM
ACO-1 WELL HISTORY
DESCRIPTION OF WELL AND LEASE

Operator: License # 5171
Name TXO Production Corp.
Address 155 N. Market, Suite 1000
City/State/Zip Wichita, Kansas, 67202

Purchaser D & A

Operator Contact Person Doug Clark
Phone 316 269-7600

Contractor: License # 5929
Name Duke Drilling Co., Inc.

Wellsite Geologist None
Phone

Designate Type of Completion
 New Well Re-Entry Workover
 Oil SWD Temp Abd
 Gas Inj Delayed Comp.
 Dry Other (Core, Water Supply etc.)

If OWO: old well info as follows:
Operator
Well Name
Comp. Date Old Total Depth

WELL HISTORY

Drilling Method:
 Mud Rotary Air Rotary Cable
3-28-87 3-30-87 3-31-87
Spud Date Date Reached TD Completion Date
2152' N/A
Total Depth PBTD
8-5/8" @ 271'
Amount of Surface Pipe Set and Cemented at...feet
Multiple Stage Cementing Collar Used? Yes No
If yes, show depth set...feet
If alternate 2 completion, cement circulated N/A
from...feet depth to...w/...SX cmt
Cement Company Name
Invoice #

API NO. 15-095-21,567-0000
County Kingman
approx N/2 SE Sec. 26 Twp. 28S Rge. 7 East X West

1980 Ft North from Southeast Corner of Section
1340 Ft West from Southeast Corner of Section
(Note: Locate well in section plat below)


Lease Name Mayer "A" Well # 1

Field Name Negra Creek

Producing Formation D & A

Elevation: Ground 1583' KB 1588'

Section Plat

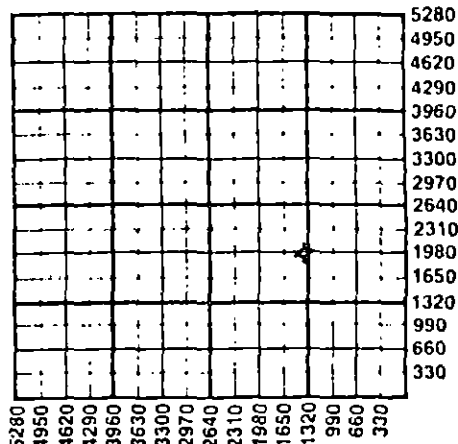

WATER SUPPLY INFORMATION

Disposition of Produced Water: Disposal
Docket # Repressuring

Questions on this portion of the ACO-1 call:

Water Resources Board (913) 296-3717

Source of Water:
Division of Water Resources Permit # T-87-124

Groundwater 1980 Ft North from Southeast Corner
(Well) 1340 Ft West from Southeast Corner of
Sec 26 Twp 28S Rge 7 East X West

Surface Water...Ft North from Southeast Corner
(Stream, pond etc)...Ft West from Southeast Corner
Sec Twp Rge East West


Other (explain) (purchased from city, R.W.D. #)

INSTRUCTIONS: This form shall be completed in triplicate and filed with the Kansas Corporation Commission, 200 Colorado Derby Building, Wichita, Kansas 67202, within 120 days of the spud date of the well. Rule 82-3-130, 82-3-107 and 82-3-106 apply. Information on side two of this form will be held confidential for a period of 12 months if requested in writing and submitted with the form. See rule 82-3-107 for confidentiality in excess of 12 months. One copy of all wireline logs and drillers time log shall be attached with this form. Submit CP-4 form with all plugged wells. Submit CP-111 form with all temporarily abandoned wells.

All requirements of the statutes, rules and regulations promulgated to regulate the oil and gas industry have been fully complied with and the statements herein are complete and correct to the best of my knowledge.

Signature Doug Clark
Title District Geologist Date

Subscribed and sworn to before me this 7th day of April 1987
Notary Public Stephanie R. Stuber
Date Commission Expires 8-31-88

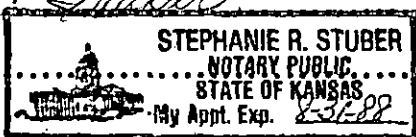

K.C.C. OFFICE USE ONLY
F Letter of Confidentiality Attached
C Wireline Log Received
C Drillers Time Log Received
Distribution
 KCC SWD/Rep NGPA
 KGS Plug Other
(Specify)

Sec 26 Twp 28S Rge 7 East

Operator Name TXO Production Corp. Lease Name Mayer "A" Well # 1

Sec....26.... Twp..28S.... Rge.....7.... East West County.....Kingman.....

WELL LOG

INSTRUCTIONS: Show important tops and base of formations penetrated. Detail all cores. Report all drill stem tests giving interval tested, time tool open and closed, flowing and shut-in pressures, whether shut-in pressure reached static level, hydrostatic pressures, bottom hole temperature, fluid recovery, and flow rates if gas to surface during test. Attach extra sheet if more space is needed. Attach copy of log.

Drill Stem Tests Taken Yes No
 Samples Sent to Geological Survey Yes No
 Cores Taken Yes No

Formation Description
 Log Sample

DST #1, 2077-2152' (Indian Cave):
 1st open: strong blow throughout.
 2nd open: strong blow throughout.
 IFP/30"=76-190 psig.
 ISIP/60"=763 psig.
 FFP/30"=248-286 psig.
 FSIP/60"=763 psig.
 Rec: 90' MW, 420' SW.

Name	Top	Bottom
Onaga	2071	- 483
Indian Cave SS	2083	- 495
Wabaunsee	2113	- 525
RTD	2152	
LTD	2152	

CASING RECORD <input type="checkbox"/> New <input checked="" type="checkbox"/> Used Report all strings set-conductor, surface, intermediate, production, etc.							
Purpose of String	Size Hole Drilled	Size Casing Set (In O.D.)	Weight Lbs/Ft.	Setting Depth	Type of Cement	#Sacks Used	Type and Percent Additives
Surface	12-1/4"	8-5/8"	24#	271'	Liteweight Class A	100 75	3% CaCl ₂ 3% CaCl ₂ 2% gel
PERFORATION RECORD				Acid, Fracture, Shot, Cement Squeeze Record			
Shots Per Foot	Specify Footage of Each Interval Perforated			(Amount and Kind of Material Used)		Depth	
N/A							
TUBING RECORD				Liner Run <input type="checkbox"/> Yes <input type="checkbox"/> No			
Date of First Production		Set At		Packer at			
D&A 3-31-87							
Producing Method <input type="checkbox"/> Flowing <input type="checkbox"/> Pumping <input type="checkbox"/> Gas Lift <input type="checkbox"/> Other (explain).....							
Estimated Production Per 24 Hours		Oil	Gas	Water	Gas-Oil Ratio	Gravity	
N/A		Bbls	N/A MCF	N/A Bbls	CFPB		

METHOD OF COMPLETION

Production Interval

Disposition of gas: Vented Open Hole Perforation
 Sold Other (Specify) D&A 3-31-87
 Used Dually Completed
 Commingled

RECEIVED
 STATE COMMISSION
 APR 2 1987
 CONSERVATION DIVISION
 WICHITA, Kansas

BJ-TITAN SERVICES COMPANY

ORIGINAL

DATE OF JOB
MM DD YY
3 28 87

CONTRACT NO. 284525

DIRECT CORRESPONDENCE TO: P.O. BOX 4442 HOUSTON, TX 77210
 TERMS: NET 30 DAYS FROM DATE OF CONTRACT
 REMIT TO: P.O. BOX 200416 HOUSTON, TX 77216

ORDER NO.

CUSTOMER
 NAME: T.X.O PRODUCTION NO. 09030270
 ADDRESS: MARKET CENTRE BUILDING #1000
 CITY: WICHITA STATE: KS ZIP CODE: 67202
 AUTHORIZED BY: CHARLES

DESCRIPTION OF WELL:
 WELL NO. 1 OIL NEW STATE: KANS CODES: 15
 GAS OLD
 LEASE NAME: MAYER COUNTY/PARISH: KENYON 007
 FIELD NAME: CITY:
 OWNER: TXO PROD. MTA DISTRICT:
 LEASE LINES:
 SURVEY LINES:
 SURVEY:
 DIRECTIONS TO LOCATION: R40 JCT 80-3E-YEN INTO
 SECTION, TOWNSHIP, RANGE: 26 28 7W
 QUADRANT:

JOB INFORMATION: ROUND TRIP MILES:
 ARRIVED: HH MM A MM DD YY: 10:30 3 28 87
 RELEASED: HH MM A MM DD YY: P 3 29 87
 JOB CODE: 0100 TYPE OF JOB: SURFACE API OR IC NO.:
 AVG. PSI: BUSINESS CODE: INJ. RATE (BPM): WORKING WELL DEPTH: 270 FT.

DIST. NO.: 3350 DISTRICT NAME: MEDICINE LODGE SLSMAN NO.:

CONTRACT CONDITIONS

This contract must be signed before the job is started or merchandise delivered. The undersigned is authorized to execute this contract as an Agent of the Customer. As such, the undersigned acknowledges that this contract for services, materials, products and/or supplies includes all of and only those terms and conditions appearing on the front and back of this document. No additional substitute terms and/or conditions shall become a part of this contract without the written consent of an Officer of BJ-TITAN SERVICES COMPANY.

SIGNED: Charles J. Paulson
 (WELL OWNER: OPERATOR, CONTRACTOR OR AGENT)

PRICE BOOK REF NO.	SERVICES/MATERIAL	U/M	QUANTITY	PRICE	EXTENSION
01 1.01.00.303	0 - 270 FT			370.00	370.00
02 1.01.09.005	PUMP TRUCK MILEAGE	E	40	1.50	60.00
03 1.04.30.53.6	8 5/8 Top Rubber Plug	E	1	58.50	58.50
04 1.09.10.5.04	CLASS A	S	75	5.00	375.00
05 1.09.15.005	LETE-WATE	S	100	4.30	430.00
06 1.09.15.049	A7-P	S	4.75	23.00	109.25
07 1.09.20.1.45	B5-T Gel	QWT	141	6.75	9.52
08 1.09.9.01.15	DTGAGE 8.2 100 X 40 MT	E	328	.68	223.04
09 1.08.8.00.95	HANDLING AND DUMPING	Q	175	.92	161.00
10					
11 1.04.3.30.83	8 5/8 GAFFE PLATE	E	1	56.70	56.70
12					18.53 01
13 24	Bid RECEIVED 350 plus Gaffe Plate		Less		447 31
14					1405 70
15					
16					

SERVICE REPRESENTATIVE: Charles J. Paulson
 PR. BOOK: 07
 TEXAS OIL & GAS CORP.
 The above material and service ordered by the Customer and received by: Charles J. Paulson
 (WELL OWNER, OPERATOR, CONTRACTOR OR AGENT)

BJ-TITAN SERVICES COMPANY

ORIGINAL

DATE OF JOB
MM DD YY
3 31 87

CONTRACT NO. 284856

DIRECT CORRESPONDENCE TO: P.O. BOX 4442 HOUSTON, TX 77210	TERMS: NET 30 DAYS FROM DATE OF CONTRACT	REMIT TO: P.O. BOX 200416 HOUSTON, TX 77216
---	--	---

ORDER NO.

CUSTOMER

NAME: *TXO PRODUCTION Corp.* NO: *09030270*

ADDRESS: *155 N. MARKET, SUITE 1000*

CITY: *WICHITA* STATE: *Ks* ZIP CODE: *67202*

AUTHORIZED BY: *JOHN AMELSTER*

DESCRIPTION OF WELL

WELL NO: *A-1* OIL GAS NEW OLD STATE: *KANSAS* CODES: *15*

LEASE NAME: *MAYERS* COUNTY/PARISH: *WENGMAN* CCY: *007*

FIELD NAME: CITY:

OWNER: *TXO PROD. Corp.* MTA DISTRICT:

LEASE LINES:

SURVEY LINES:

SURVEY:

DIRECTIONS TO LOCATION: *14442 Jct. 3N, 3 1/2 E M5*

SECTION, TOWNSHIP, RANGE: *26 28S 7W*

QUADRANT: *C N/2 SE*

JOB INFORMATION

ARRIVED: HH:MM:SS *12:00* P. A:MM:DD:YY *3 31 87*

RELEASED: HH:MM:SS *2:30* P. A:MM:DD:YY *3 31 87*

JOB CODE: *0115* TYPE OF JOB: *HUG TO ABANDON* API OR IC NO.: *15-075-21567*

AVG. PSI: BUSINESS CODE: INJ. RATE (BPM): WORKING WELL DEPTH: *2152 FT.*

DIST. NO.: *3350* DISTRICT NAME: *MEDICINE LODGE, Ks* SLSMAN NO.:

CONTRACT CONDITIONS

This contract must be signed before the job is started or merchandise delivered. The undersigned is authorized to execute this contract as an Agent of the Customer. As such, the undersigned acknowledges that this contract for services, materials, products and/or supplies includes all of and only those terms and conditions appearing on the front and back of this document. No additional substitute terms and/or conditions shall become a part of this contract without the written consent of an Officer of BJ-TITAN SERVICES COMPANY.

SIGNED: *Delwayne Chian*
(WELL OWNER: OPERATOR, CONTRACTOR OR AGENT)

PRICE BOOK REF. NO.	SERVICES/MATERIAL	U/M	QUANTITY	PRICE	EXTENSION
01 1.0.10.9.8.1.6	PUMP CHARGE	E	1	650.00	650.00
02 1.0.10.9.0.0.5	PUMP TRUCK MILEAGE	E	40	150	60.00
03 1.0.4.1.0.5.0.4	CLASS A	S	66	500	33000
04 1.0.4.1.5.0.1.8	PREMIX	S	44	200	8800
05 1.0.4.2.0.1.4.5	BJ-TITAN OIL	S	3.78	675	2552
06 1.0.4.3.0.5.3.8	3 1/2" DRY HOSE PUMPS	E	1	900	900
07 1.0.3.3.0.0.9.5	HANDLING + DUMPING	Q	110	92	10120
08 1.0.9.4.0.1.1.5	DRAYAGE 4.9 X 40	E	196	68	13328
09	SUBTOTAL				139700
10	LESS 20% DISC				27940
11	TOTAL				\$111760
				RECEIVED	
				APR - 6 1987	
				TEXAS OIL & GAS CORP.	
				WICHITA	
				WICHITA, KANSAS	

SERVICE REPRESENTATIVE: *Kevin Bankston* PR. BOOK: *07*

The above material and service ordered by the Customer and received by: *Delwayne Chian*
(WELL OWNER, OPERATOR, CONTRACTOR OR AGENT)