

\* Amended  
STATE CORPORATION COMMISSION OF KANSAS  
OIL & GAS CONSERVATION DIVISION  
WELL COMPLETION OR RECOMPLETION FORM  
ACO-1 WELL HISTORY  
DESCRIPTION OF WELL AND LEASE

Operator: License # 3711  
Name Shepler & Thomas, Inc.  
Address P.O. Box 1162  
City/State/Zip Liberal, KS 67905-1162

Purchaser N/A

Operator Contact Person R. F. Burke  
Phone (316) 624-0750

Contractor: License # 5302  
Name Red Tiger Drilling

Wellsite Geologist Lynn Tucker  
Phone (719) 395-6047

Designate Type of Completion  
 New Well  Re-Entry  Workover  
 Oil  SWD  Temp Abd  
 Gas  Inj  Delayed Comp.  
 Dry  Other (Core, Water Supply etc.)

If OWMs old well info as follows:  
Operator  
Well Name  
Completion Date

WELL HISTORY

Drilling Methods:  Mud Rotary  Air Rotary  Cable

3-14-89 3-18-89 N/A 3-19-89  
Spud Date Date Reached TD Completion Date

2700 0  
Total Depth PBTD

Amount of Surface Pipe Set and Cemented at 230 feet  
Multiple Stage Cementing Collar Used? Yes  No  
If yes, show depth set  
If alternate 2 completion, cement circulated from feet depth to w/ SX cmt  
Cement Company Name  
Invoice #


INSTRUCTIONS: This form shall be completed in triplicate and filed with the Kansas Corporation Commission, 200 Colorado Derby Building, Wichita, Kansas 67202, within 120 days of the spud date of any well. Rule 82-3-130, 82-3-107 and 82-3-106 apply.

Information on side two of this form will be held confidential for a period of 12 months if requested in writing and submitted with the form. See rule 82-3-107 for confidentiality in excess of 12 months. One copy of all wireline logs and drillers time log shall be attached with this form. Submit CP-4 form with all plugged wells. Submit CP-111 form with all temporarily abandoned wells.

All requirements of the statutes, rules and regulations promulgated to regulate the oil and gas industry have been fully complied with and the statements herein are complete and correct to the best of my knowledge.

Signature R. F. BURKE  
Title Agent Date 3-21-89

Subscribed and sworn to before me this 21st day of March 1989  
Notary Public JODY PHELPS  
Date Commission Expires January 28, 1991

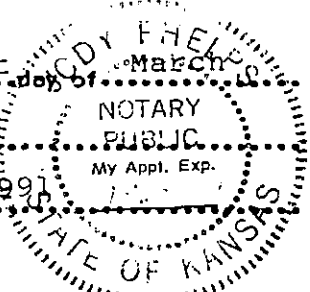

API NO. 15-095-21603-0000  
County Kingman  
Approx SW NE 10 28S 10 East  
Sec. Twp. Rge. X West

3400 Ft North from Southeast Corner of Section  
1980-1880 Ft West from Southeast Corner of Section  
(Note: Locate well in section plat below)


Lease Name Vermillion Well # 1-10

Field Name N/A

Producing Formation N/A

Elevation: Ground 1694 KB 1700

Section Plat

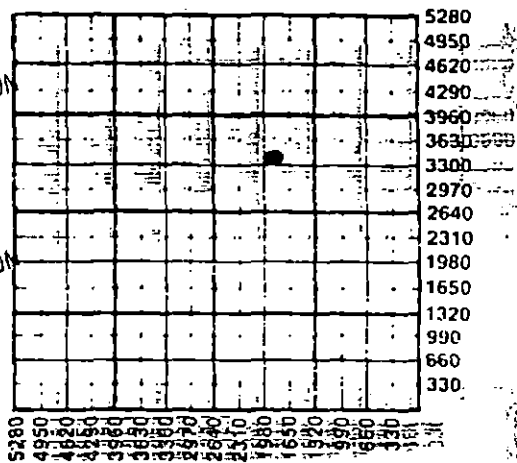

5-23-89  
RECEIVED  
STATE CORPORATION COMMISSION  
MAY 23 1989  
CONSERVATION DIVISION  
Wichita, Kansas

WATER SUPPLY INFORMATION

Disposition of Produced Water: Disposal  
Docket #: Repressuring

Questions on this portion of the ACO-1 call:  
Water Resources Board (913) 296-3717  
Source of Water:  
Division of Water Resources Permit # T89-122

Groundwater 2300 Ft North from Southeast Corner  
(Well) 2000 Ft West from Southeast Corner of  
10 Sec 28 Twp 10 Rge East  West  
 Surface Water Ft North from Southeast Corner  
(Stream, pond etc) Ft West from Southeast Corner  
Sec Twp Rge East West  
 Other (explain)  
(purchased from city, R.W.D. #)

K.C.C. OFFICE USE ONLY  
 Letter of Confidentiality Attached  
 Wireline Log Received  
 Drillers Time Log Received  
Distribution  
 KCC  SWD/Rep  NGPA  
 KGS  Plug  Other  
(Specify)  
3-23-89  
Form ACO-1 (5-86)

Sec 10 Twp 28 Rge 10 E