

STATE CORPORATION COMMISSION OF KANSAS
OIL & GAS CONSERVATION DIVISION
WELL COMPLETION OR RECOMPLETION FORM
ACO-1 WELL HISTORY
DESCRIPTION OF WELL AND LEASE

API NO. 15-095-21606-0000

County Kingman

Sec. 24 Twp. 28S Rge. 10 East West

3300 Ft North from Southeast Corner of Section
3300 Ft West from Southeast Corner of Section
(Note: Locate well in section plat below)


Lease Name Dyche Well # 1-24

Field Name N/A

Producing Formation Indian Cave

Elevation: Grounds 1735 KB 1741

Section Plat

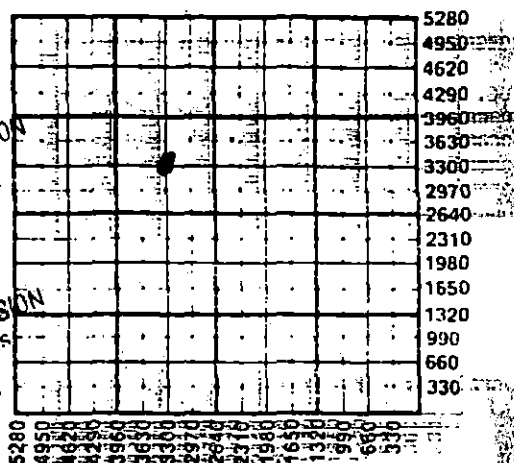

Operator: License # 3711
Name Shepler & Thomas, Inc.
Address P.O. Box 1162
City/State/Zip Liberal, KS 67905-1162

Purchaser N/A

Operator Contact Person R. F. Burke
Phone (316) 624-0750

Contractor: License # 5302
Name Red Tiger

Wellsite Geologist Lynn Tucker
Phone

Designate Type of Completion
 New Well Re-Entry Workover

Oil SWD Temp Abd
 Gas Inj Delayed Comp.
 Dry Other (Core, Water Supply, etc.)

If ~~OWO~~ old well info as follows:
Operator
Well Name
Comp Date Old Total Depth

WELL HISTORY

Drilling Method: Mud Rotary Air Rotary Cable

Spud Date 3-22-89 Date Reached TD 3-25-89 Completion Date N/A 3-25-89

Total Depth 2700 PBD 0

Amount of Surface Pipe Set and Cemented at 232 feet
Multiple Stage Cementing Collar Used? Yes No
If yes, show depth set feet
If alternate 2 completion, cement circulated from feet depth to w/ SX cmt
Cement Company Name
Invoice #

RECEIVED
MAR 30 1989
3-30-89
CONSERVATION DIVISION
Wichita, Kansas

WATER SUPPLY INFORMATION

Disposition of Produced Water: Disposal Repressuring
Docket #

Questions on this portion of the ACO-1 call:
Water Resources Board (913) 296-3717

Source of Water: T89-133
Division of Water Resources Permit #

Groundwater 3300 Ft North from Southeast Corner
(Well) 3300 Ft West from Southeast Corner of
24 Sec 28S Twp 10 Rge East West

Surface Water Ft North from Southeast Corner
(Stream, pond etc) Ft West from Southeast Corner
Sec Twp Rge East West

Other (explain)
(purchased from city, R.W.D. #)


INSTRUCTIONS: This form shall be completed in triplicate and filed with the Kansas Corporation Commission, 200 Colorado Derby Building, Wichita, Kansas 67202, within 120 days of the spud date of any well. Rule 82-3-130, 82-3-107 and 82-3-106 apply.

Information on side two of this form will be held confidential for a period of 12 months if requested in writing and submitted with the form. See rule 82-3-107 for confidentiality in excess of 12 months. One copy of all wireline logs and drillers time log shall be attached with this form. Submit CP-4 form with all plugged wells. Submit CP-111 form with all temporarily abandoned wells.

All requirements of the statutes, rules and regulations promulgated to regulate the oil and gas industry have been fully complied with and the statements herein are complete and correct to the best of my knowledge.

Signature R.F. Burke
R. F. BURKE
Agent
Title Date 3-29-89

Subscribed and sworn to before me this 29th day of March 1989
Notary Public Jody Phelps
Date Commission Expires January 28, 1991

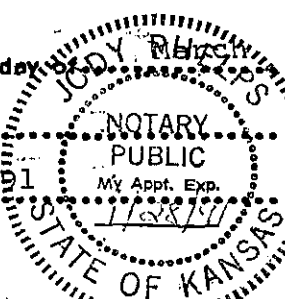

K.C.C. OFFICE USE ONLY
 Letter of Confidentiality Attached
 Wireline Log Received
 Drillers Timelog Received
Distribution
 KCC SWD/Rep NGPA
 KGS Plug Other
(Specify)
3-30-89

Sec 24 Twp 28S Rge 10E