

15-095-20967-0500


STATE OF KANSAS
STATE CORPORATION COMMISSION

WELL PLUGGING RECORD

Give All Information Completely
Make Required Affidavit
Mail or Deliver Report to
Conservation Division
State Corporation Comm.
245 North Water
Wichita, KS 67202

Kingman County. Sec. 18 Twp. 28S Rge. 5W xxx
Location as "NE/CNW $\frac{1}{4}$ SW $\frac{1}{4}$ " or footage from lines
NE SW SE

Lease Owner D. R. Lauck Oil Company, Inc.
Lease Name Delp Well No. 2
Office Address 221 S. Broadway, Wichita, Kansas 67202
Character of Well (Completed as Oil, Gas or Dry Hole) Dry Hole

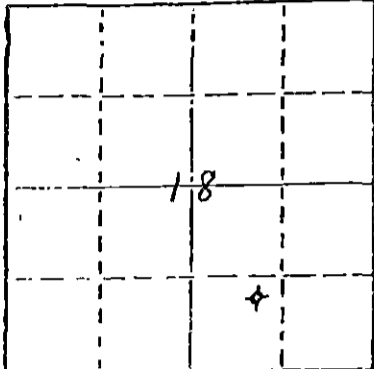

Locate well correctly on above Section Plat

Date Well completed June 20, 1980
Application for plugging filed June 20, 1980
Application for plugging approved June 20, 1980
Plugging commenced June 20, 1980
Plugging completed June 20, 1980
Reason for abandonment of well or producing formation Dry Hole

If a producing well is abandoned, date of last production 19__

Was permission obtained from the Conservation Division or its agents before plugging was commenced? Yes

Name of Conservation Agent who supervised plugging of this well William T. Owen
Producing formation _____ Depth to top _____ Bottom _____ Total Depth of Well 3915'
Show depth and thickness of all water, oil and gas formations.

OIL, GAS OR WATER RECORDS

CASING RECORD

FORMATION	CONTENT	FROM	TO	SIZE	PUT IN	PULLED OUT
		0'	298'	8-5/8"	291.55'	None

Describe in detail the manner in which the well was plugged, indicating where the mud fluid was placed and the method or methods used in introducing it into the hold. If cement or other plugs were used, state the character of same and depth placed, from _____ feet to _____ feet for each plug set.

Plugged with plug and 40 sacks cement at 300';
plug and 10 sacks cement at 40'; and 5 sacks
cement in rat hole.

(If additional description is necessary, use BACK of this sheet)

Name of Plugging Contractor Allied Cementing Co.

STATE OF KANSAS COUNTY OF SEDGWICK


John D. Knightley (employee of owner) or _____ (owner or operator)
of the above-described well, being first duly sworn on oath, says: That I have knowledge of the facts, statements, and matters herein contained and the log of the above-described well as filed and that the same are true and correct. So help me God.

(Signature) [Signature]
221 S. Broadway, Wichita, Kansas 67202
(Address)

SUBSCRIBED AND SWORN TO before me this 3rd day of July, 1980
PUBLIC

My commission expires March 12, 1983

[Signature] Notary Public.

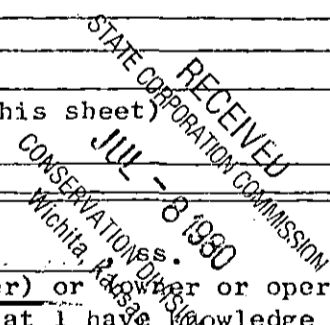

15-095-20967-0500

D. R. Lauck Oil Company, Inc. -
221 S. Broadway, Suite 400
Wichita, Kansas 67202

Delp #2
NE SW SE Sec. 18-28S-5W
Kingman County, Kansas

Contractor: D. R. Lauck Oil Company, Inc.

Commenced: June 10, 1980
Completed: June 20, 1980

Drillers Log

Red Bed & Sand	301
Shale & Shells	630
Shale	1330
Shale & Lime	3527
Lime & Shale	3780
Shale & Lime	3850
Lime & Shale	3865
Shale & Lime	3875
Lime & Shale	3875
Shale & Lime	3915 RTD

RECEIVED
STATE CORPORATION COMMISSION
JUL - 8 1980
CONSERVATION DIVISION
Wichita, Kansas